MISSISSIPPI DEPARTMENT OF ENVIRONMENTAL QUALITY
Office of Land and Water Resources

P. O. Box 10631
Jackson, MS 39289-0631
WATER WELL DRILLERS LOG

COUNTY WELL LOCATED	TATE
WELL NUMBER	N-32
CODED	
DATE WELL COMPLETED	11-14-00
PERMIT NUMBER	
NAME OF DRILLING FIRM	[illegible]

NAME & MAILING ADDRESS OF LANDOWNER: B. Haynes Floyd
P.O. Box 518
Como, MS 38619

WELL LOCATION	SEC	TOWNSHIP	RANGE
	18	6 N (S)	6 E (W)

DISTANCE	DIRECTION	NEAREST TOWN
1 Miles	S of	Springfield

OTHER LANDMARK:

WELL PURPOSE Home, Irrigation, Municipal, Industrial, Fish Pond, etc.: Kennell

PUMP DATA

PUMP TYPE (Circle One): (Submersible) Turbine, Jet, Flowing Well, Other (Describe)

POWER TYPE (Circle One): (Electric) Tractor, Diesel, Gasoline, Butane, Other (Describe) H/P 1½

Pump Capacity (GPM)	No of Stages	Setting Depth
20		100 FT.

PUMP TEST

Well yielded ____ GPM with a drawdown of ____ ft. after ____ hours of pumping

WELL DATA

Well Depth	Casing Diameter (In.)	Casing Length (Ft.)
153	4	133

Type of Casing	Hole Depth	Depth to Static Water Level
PVC	153	70

TYPE OF COMPLETION: (Circle One or More): (Gravel Packed) Underreamed, Telescoped, Natural Development, Open Hole, Other (Describe)

WELL GROUTED TO A DEPTH OF 3 FEET
Type Grout (circle one): Cement, (Bentonite), or Mix

LOG DATA

TYPE OF LOG RUN (Circle One): (No Log Run) Electric, Gamma Ray, Density, Sonic, Neutron, Other (Describe)

Name of Organization Running Log

GEOLOGIC DATA (Office Use Only)

Surface Elev	Geologic Unit	Unit Thickness	Depth to Top
Subs SWL	Date NOV 27 2000	Analysis	Aquifer Test

Driller's Remarks

Dept. of Environmental Quality
Office of Land & Water Resources

Top of Lap Pipe or Reduction in Casing: FEET

IF TELESCOPED OR MORE THAN ONE SCREEN: USE BACK PAGE

SCREEN DATA

Diameter - Inches	Length - Feet	Slot Size - Inches
4	20	.013

Screen Type	Depth to Bottom - Feet
PVC Slotted	133'

DESCRIPTION OF FORMATIONS ENCOUNTERED	FROM	TO
Red Clay	0	15
Red Sand & Clay	15	30
Red Sand & Rear ground	30	70
White Sand & Clay	70	100

FORMATIONS (Continued)	FROM	TO
White Sand	100	153

IF MORE SPACE IS NEEDED, USE BACK

If well telescopes please sketch and show depths.

GROUND LEVEL

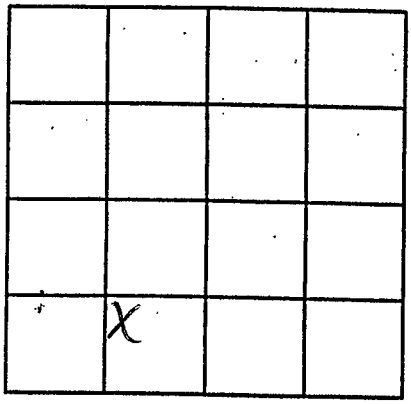

SECTION 18

Please indicate well location X.

ADDITIONAL INFORMATION

If more than one screen,