MISSISSIPPI DEPARTMENT OF NATURAL RESOURCES

Bureau of Land and Water Resources

P.O. Box 10631
Jackson, Mississippi 39209
WATER WELL DRILLERS LOG

COUNTY WELL LOCATED	TATE
WELL NUMBER	N
CODED	
	2044
DATE WELL COMPLETED	6-23-88
PERMIT NUMBER	
NAME OF DRILLING FIRM	[illegible] WELL COMPANY
	RT. 1 - BOX 157
	SENATOBIA, MISS.

NAME & MAILING ADDRESS OF LANDOWNER

Curly James Const.
Rt. 1
Senatobia, Ms. 38668

WELL LOCATION: SEC 17 TOWNSHIP 6 N RANGE 6 E

DISTANCE 2 Miles DIRECTION E NEAREST TOWN of Springfield

OTHER LANDMARK

WELL PURPOSE: Home, Irrigation, Municipal, Industrial, Fish Pond, etc.

PUMP DATA

PUMP TYPE (Circle One): Submersible, Turbine, Jet Flowing Well, Other (Describe) _____

POWER TYPE (Circle One): Electric, Tractor, Diesel, Gasoline, Butane, Other (Describe) _____

Pump Capacity (GPM)	No. of Stages	Setting Depth
10	9	100 FT.

PUMP TEST

Well yielded _____ GPM with a drawdown of _____ ft. after _____ hours of pumping

WELL DATA

Well Depth	Casing Diameter (In.)	Casing Length (Ft.)
150	4	140
Type of Casing	**Hole Depth**	**Depth to Static Water Level**
PVC	150	80

TYPE OF COMPLETION: (Circle One or More): Gravel Packed, Underreamed, Telescoped, Natural Development, Open Hole, Other (Describe) _____

Top of Lap Pipe or Reduction in Casing FEET

IF TELESCOPED OR MORE THAN ONE SCREEN: USE BACK PAGE

SCREEN DATA

Diameter - Inches	Length - Feet	Slot Size - Inches
4	10	013
Screen Type		**Depth to Bottom - Feet**
PVC		—

LOG DATA

TYPE OF LOG RUN (Circle One): No Log Run, Electric, Gamma Ray, Density, Sonic, Neutron, Other (Describe) _____

Name of Organization Running Log

GEOLOGIC DATA (Office Use Only)

Surface Elev.	Geologic Unit	Unit Thickness	Depth to Top
Subs. SWL	Date	Analysis	Aquifer Test

Driller's Remarks

RECEIVED
SEP 21 1988
Department of Natural Resources
Bureau of Land & Water Resources

DESCRIPTION OF FORMATIONS ENCOUNTERED	FROM	TO
Red Clay	0	10
Red Sand	10	50
White Sand	50	150

FORMATIONS (Continued)	FROM	TO

IF MORE SPACE IS NEEDED, USE BACK

If well telescopes please
sketch and show depths.

GROUND LEVEL

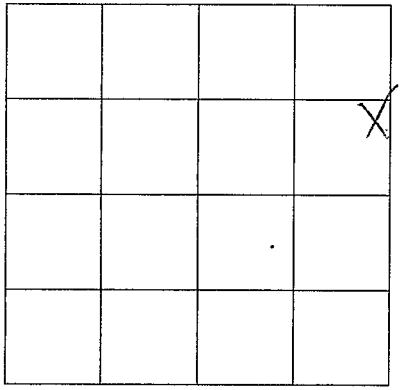

SECTION 17

Please indicate well location X.

ADDITIONAL INFORMATION

If more than one screen,
show location of each on sketch.