

MISSISSIPPI DEPARTMENT OF NATURAL RESOURCES

Bureau of Land and Water Resources

Southport Mall

P.O. Box 10631

Jackson, Mississippi 39209

WATER WELL DRILLERS LOG

CODED

TIPPAH
A 36

2/20/86 19
date well completed

Wilson Wells Co. Inc.
firm name

Tippah
county well located

LANDOWNER: Clanton Pollita

P.O. Box 66

Walnut Miss. 38658
(mailing address)

WELL LOCATION:

sec. 35 T-1 N R-3 E
 1 miles W. of Walnut
 (distance) (direction) (nearest town)

WELL PURPOSE: Trailer Park
 (home, irrigation, municipal, industrial)

WELL COMPLETION DATA:

- (1) diameter (inches) 4"
- (2) total depth (feet) 245
- (3) static water level (feet) 100 below above top of ground.
- (4) casing PVC, 215,
 (material) (depth)
4" If telescope see back.
 (size)
- (5) screen 30,
 (length) (depth to top)
4", PVC
 (size) (material)
- (6) pump 2,
 (HP) (yield gpm)
elect.
 (type power)
- (7) electric log no
 (yes or no)
 (organization running log)
- (8) how well bottom plugged


description of formations encountered

from

to

Red Clay	0	5
Rock	5	6
White Clay - white sand	6	15
White Sand	15	45
White Sand - Brown Clay	45	60
Brown Clay	60	105
Brown Clay	105	155
Rock	155	156
Brown Clay - Rock - Sand	156	195
Green Sand - Small Rock	195	225
Rock	225	226
Green Sand	226	235
Rock	235	236
Green Sand	236	245

CODED

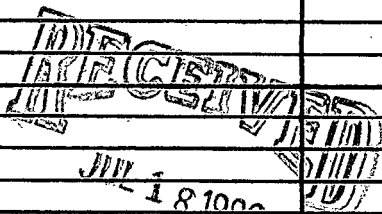


Department of Natural Resources
 Bureau of Land & Water Resources

DRILLERS REMARKS:

If well telescopes please sketch and show depths.

GROUND LEVEL

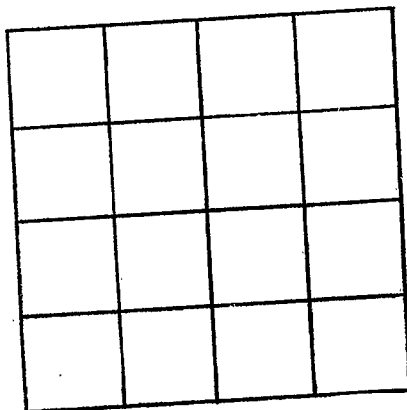

SECTION _____

Please indicate well location X.

ADDITIONAL INFORMATION

If more than one screen,
show locations of each on sketch.