TIPPAH
D 15
5-1-72

MISSISSIPPI
BOARD OF WATER COMMISSIONERS
416 North State Street
Jackson, Mississippi 39201

CODED

WATER WELL DRILLERS LOG

5-1-72 19 — Jungendwell Drilling — Tippah
date well completed — firm name — county well located

LANDOWNER: Jonie Bee Jones
RFD #1 Walnut, Miss.
(mailing address)

WELL LOCATION:
sec. 6 T 2 N (S) R 4 E (W)
3 miles W. of Walnut
(distance) (direction) (nearest town)

WELL PURPOSE: home
(home, irrigation, municipal, industrial)

WELL COMPLETION DATA:
(1) diameter (inches) 4"
(2) total depth (feet) 230
(3) static water level (feet) 60 below ~~above~~ top of ground.
(4) casing PVC (material), 70 (depth),
_____ (size) if telescope see back.
(5) screen 0 (length), 0 (depth to top)
0 (size), 0 (material)
(6) pump 1 (HP) 7 (yield gpm)
Elec (type power)
(7) electric log no (yes or no)
0 (organization running log)
(8) how well bottom plugged 0

DRILLERS REMARKS:

description of formations encountered	from	to
Grey Clay	0	180
Sand & rock	180	230

CODED

DEC 11 1972
MISS. BD. OF WATER COMM.

If well telescopes please sketch and show depths.

GROUND LEVEL

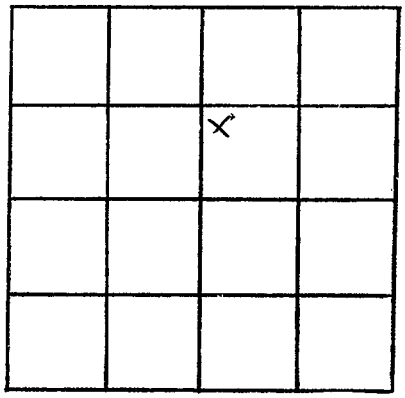

SECTION 6

Please indicate well location X.

ADDITIONAL INFORMATION

If more than one screen, show locations of each on sketch.