MISSISSIPPI DEPARTMENT OF ENVIRONMENTAL QUALITY
Office of Land and Water Resources

P. O. Box 10631
Jackson, MS 39289-0631
WATER WELL DRILLERS LOG

COUNTY WELL LOCATED: Tippah	
WELL NUMBER: 2019	CODED
DATE WELL COMPLETED: 4 28 2000	PERMIT NUMBER
	NAME OF DRILLING FIRM: MEDLIN

NAME & MAILING ADDRESS OF LANDOWNER
John Fick
Ripley MS Rt 2

WELL LOCATION: SEC 2 TOWNSHIP 4 N (S) RANGE 3 (E) W

DISTANCE 3 Miles DIRECTION W of NEAREST TOWN Ripley

OTHER LANDMARK Orman's Sport Store

WELL PURPOSE: Home, Irrigation, Municipal, Industrial, (Fish Pond), etc.

PUMP DATA

PUMP TYPE (Circle One): (Submersible) Turbine, Jet Flowing Well, Other (Describe) _____

POWER TYPE (Circle One): (Electric) Tractor, Diesel, Gasoline, Butane, Other (Describe) _____ H/P 1

Pump Capacity (GPM)	No. of Stages	Setting Depth
18	12	70 FT.

PUMP TEST
Well yielded 18 GPM with a drawdown of 6 ft. after 12 hours of pumping

WELL DATA

Well Depth	Casing Diameter (In.)	Casing Length (Ft.)
210	~~100~~ 4	100
Type of Casing	**Hole Depth**	**Depth to Static Water Level**
PVC	210	25

TYPE OF COMPLETION: (Circle One or More): Gravel Packed, Underreamed, Telescoped, Natural Development, (Open Hole), Other (Describe) _____

WELL GROUTED TO A DEPTH OF 10 FEET
Type Grout (circle one): Cement, Bentonite, (or Mix)

LOG DATA

TYPE OF LOG RUN (Circle One): No Log Run, Electric, Gamma Ray, Density, Sonic, Neutron, Other (Describe) _____

Name of Organization Running Log

GEOLOGIC DATA (Office Use Only)

Surface Elev.	Geologic Unit	Unit Thickness	Depth to Top
Subs. SWL	Date	Analysis	Aquifer Test

Driller's Remarks

SCREEN DATA

Diameter - Inches	Length - Feet	Slot Size - Inches
~~2"~~	~~60~~	~~Home Made~~
Screen Type	**Depth to Bottom - Feet**	
~~PVC~~		

Top of Lap Pipe or Reduction in Casing
FEET IF TELESCOPED OR MORE THAN ONE SCREEN, USE BACK PAGE

RECEIVED
JUN 21 2000
Dept. of Environmental Quality
Office of Land & Water Resources

DESCRIPTION OF FORMATIONS ENCOUNTERED	FROM	TO
top Soil, rock	0	60
Blue clay	60	130
lime rock,	130	220
aquifer		

FORMATIONS (Continued)	FROM	TO
IF MORE SPACE IS NEEDED, USE BACK		

If well telescopes please
sketch and show depths.

GROUND LEVEL

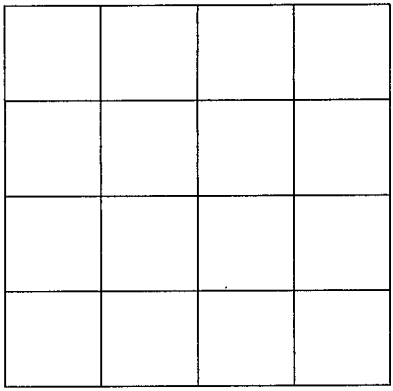

SECTION _____

Please indicate well location X.

ADDITIONAL INFORMATION

If more than one screen,
show location of each on sketch.