COUNTY WELL LOCATED	
Tippah	
WELL NUMBER	CODED
M-31	
DATE WELL COMPLETED	
9-18-02	

PERMIT NUMBER
NAME OF DRILLING FIRM
MEDLIN

MISSISSIPPI DEPARTMENT OF ENVIRONMENTAL QUALITY
Office of Land and Water Resources

P. O. Box 10631
Jackson, MS 39289-0631
WATER WELL DRILLERS LOG

NAME & MAILING ADDRESS OF LANDOWNER
Bobby CLARK
Co Rd 800
Blue Mt MS 38610

WELL LOCATION: SEC 6 TOWNSHIP 5 N/S RANGE 2 E/W

DISTANCE 1 Miles DIRECTION N/W NEAREST TOWN Blue Mtn

OTHER LANDMARK

WELL PURPOSE: Home, Irrigation, Municipal, Industrial, Fish Pond, etc.

PUMP DATA

PUMP TYPE (Circle One): Submersible, Turbine, Jet Flowing Well, Other (Describe)

POWER TYPE (Circle One): Electric, Tractor, Diesel, Gasoline, Butane, Other (Describe) H/P 3/4

Pump Capacity (GPM)	No. of Stages	Setting Depth
10	12	170 FT.

PUMP TEST

Well yielded 10 GPM with a drawdown of 5 ft. after 6 hours of pumping

WELL DATA

Well Depth	Casing Diameter (In.)	Casing Length (Ft.)
180'	4"	170
Type of Casing	**Hole Depth**	**Depth to Static Water Level**
PVC	180	155'

TYPE OF COMPLETION: (Circle One or More): Gravel Packed, Underreamed, Telescoped, Natural Development, Open Hole, Other (Describe)

WELL GROUTED TO A DEPTH OF 15 FEET
Type Grout (circle one): Cement, Bentonite, or Mix

LOG DATA

TYPE OF LOG RUN (Circle One): No Log Run, Electric, Gamma Ray, Density, Sonic, Neutron, Other (Describe)

Name of Organization Running Log

GEOLOGIC DATA (Office Use Only)

Surface Elev.	Geologic Unit	Unit Thickness	Depth to Top
Subs. SWL	Date	Analysis	Aquifer Test

Driller's Remarks

Top of Lap Pipe or Reduction in Casing
FEET
IF TELESCOPED OR MORE THAN ONE SCREEN: USE BACK PAGE

SCREEN DATA

Diameter - Inches	Length - Feet	Slot Size - Inches
4	10	0.13
Screen Pipe		**Depth to Bottom - Feet**
PVC		170 - 180

DESCRIPTION OF FORMATIONS ENCOUNTERED	FROM	TO	FORMATIONS (Continued)	FROM	TO
top Soil, clay	0	100			
Clay, fine Rock	100	155			
aquifer	155	180			
good Coarse Sand					
			IF MORE SPACE IS NEEDED, USE BACK		

RECEIVED
DEC 09 2002
BY: OLWR

If well telescopes please
sketch and show depths.

GROUND LEVEL

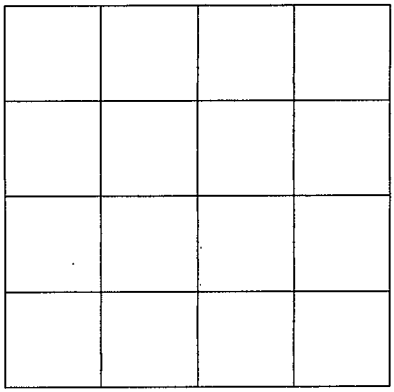

SECTION _____

Please indicate well location X.

ADDITIONAL INFORMATION

If more than one screen,
show location of each on sketch.