TIPPAH
N
2007

MISSISSIPPI
BOARD OF WATER COMMISSIONERS
416 North State Street
Jackson, Mississippi 39201

WATER WELL DRILLERS LOG

4-12-78 19 — date well completed
Bryants Well Drilling — firm name
Tippah — county well located

LANDOWNER: Kel-Reed Farms
Blue Mtn Miss
(mailing address)

WELL LOCATION:
sec. 3 T 5 N (S) R 3 (E) W ?
1½ (distance) miles South (direction) of Blue Mtn (nearest town)

WELL PURPOSE: Home & farming
(home, irrigation, municipal, industrial)

WELL COMPLETION DATA:
(1) diameter (inches) 4"
(2) total depth (feet) 300
(3) static water level (feet) 60 below above top of ground.
(4) casing Plas (material), 180 (depth),
_____ (size) if telescope see back.
(5) screen _____ (length), _____ (depth to top)
_____ (size), _____ (material)
(6) pump 1 (HP) 40 (yield gpm)
Elec (type power)
(7) electric log _____ (yes or no)
_____ (organization running log)
(8) how well bottom plugged Open

DRILLERS REMARKS:

description of formations encountered	from	to
Mixed Clay	0	35
Clay & Rock	35	60
Blue Clay	60	170
Rock & Clay	170	230
Sand & Rock	230	300

RECEIVED
AUG - 3 1978
MISS. BD. OF WATER COMM

If well telescopes please sketch and show depths.

GROUND LEVEL

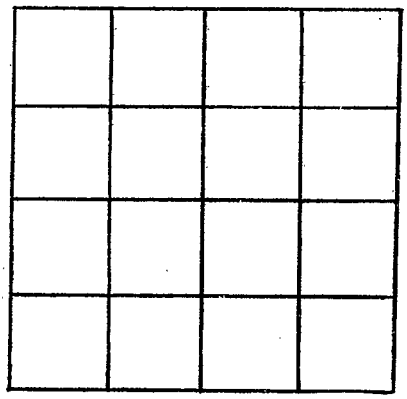

SECTION _____

Please indicate well location X.

ADDITIONAL INFORMATION

If more than one screen, show locations of each on sketch.