MISSISSIPPI DEPARTMENT OF NATURAL RESOURCES

Bureau of Land and Water Resources

P.O. Box 10631
Jackson, Mississippi 39209
WATER WELL DRILLERS LOG

COUNTY WELL LOCATED: Tippah

WELL NUMBER: Tippah N 2017 | CODED:

DATE WELL COMPLETED: 4-5-88

PERMIT NUMBER:

NAME OF DRILLING FIRM: Medlin Well Drilling

NAME & MAILING ADDRESS OF LANDOWNER: Ricky Shaten, Cotton Plant, MS.

WELL LOCATION: SEC 28 TOWNSHIP 5 N (S) RANGE 3 (E) W

DISTANCE 3 Miles DIRECTION South of NEAREST TOWN Blue Mtn.

OTHER LANDMARK:

WELL PURPOSE: Home, Irrigation, Municipal, Industrial, Fish Pond, etc.

PUMP DATA

PUMP TYPE (Circle One): Submersible, Turbine, Jet, Flowing Well, Other (Describe)

POWER TYPE (Circle One): Electric, Tractor, Diesel, Gasoline, Butane, Other (Describe) H/P 1/2

Pump Capacity (GPM)	No. of Stages	Setting Depth
8		FT.

PUMP TEST

Well yielded _____ GPM with a drawdown of _____ ft. after _____ hours of pumping

WELL DATA

Well Depth	Casing Diameter (In.)	Casing Length (Ft.)
240'	4"	180'

Type of Casing	Hole Depth	Depth to Static Water Level
PVC		

TYPE OF COMPLETION: (Circle One or More): Gravel Packed, Underreamed, Telescoped, Natural Development, Open Hole, Other (Describe)

Top of Lap Pipe or Reduction in Casing FEET

IF TELESCOPED OR MORE THAN ONE SCREEN: USE BACK PAGE

LOG DATA

TYPE OF LOG RUN (Circle One): No Log Run, Electric, Gamma Ray, Density, Sonic, Neutron, Other (Describe)

Name of Organization Running Log

GEOLOGIC DATA (Office Use Only)

Surface Elev.	Geologic Unit	Unit Thickness	Depth to Top
Subs. SWL	Date	Analysis	Aquifer Test

Driller's Remarks

RECEIVED
SEP 28 1989
Department of Natural Resources
Bureau of Land & Water Resources

SCREEN DATA

Diameter - Inches	Length - Feet	Slot Size - Inches

Screen Type	Depth to Bottom - Feet

DESCRIPTION OF FORMATIONS ENCOUNTERED	FROM	TO
Top Soil & Clay	0	120
Rock & Clay	120	180
Sand & Aquafir	180	240

FORMATIONS (Continued)	FROM	TO

IF MORE SPACE IS NEEDED, USE BACK

If well telescopes please
sketch and show depths.

GROUND LEVEL

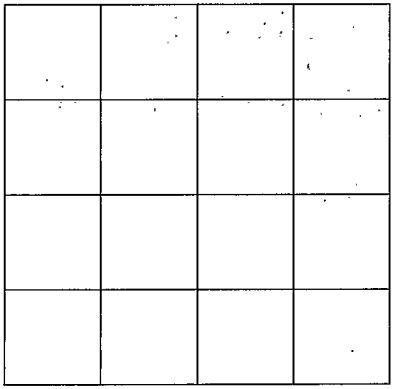

SECTION _____

Please indicate well location X.

ADDITIONAL INFORMATION

If more than one screen,
show location of each on sketch.