MISSISSIPPI DEPARTMENT OF ENVIRONMENTAL QUALITY
Office of Land and Water Resources

P. O. Box 10631
Jackson, MS 39289-0631
WATER WELL DRILLERS LOG

COUNTY WELL LOCATED: Tippah
WELL NUMBER: N 2018 CODED
DATE WELL COMPLETED: 2/22/96

PERMIT NUMBER:
NAME OF DRILLING FIRM: Wilson

NAME & MAILING ADDRESS OF LANDOWNER
Jason Hell
1950 CR 701
Ripley Ms 38663

WELL LOCATION: SEC 8 TOWNSHIP T5S N S RANGE R3 E W

DISTANCE 9 Miles DIRECTION S of NEAREST TOWN Ripley

OTHER LANDMARK

WELL PURPOSE: Home, Irrigation, Municipal, Industrial, Fish Pond, etc.
Home

PUMP DATA

PUMP TYPE (Circle One): (Submersible,) Turbine, Jet Flowing Well, Other (Describe)

POWER TYPE (Circle One): (Electric,) Tractor, Diesel, Gasoline, Butane, Other (Describe) H/P

Pump Capacity (GPM)	No. of Stages	Setting Depth
10		150 FT.

PUMP TEST
Well yielded _____ GPM with a drawdown of _____ ft. after _____ hours of pumping

WELL DATA

Well Depth	Casing Diameter (In.)	Casing Length (Ft.)
160	4"	150

Type of Casing	Hole Depth	Depth to Static Water Level
PVC	160	135

TYPE OF COMPLETION: (Circle One or More): (Gravel Packed,) Underreamed, Telescoped, Natural Development, Open Hole, Other (Describe)

WELL GROUTED TO A DEPTH OF _____ FEET
Type Grout (circle one): Cement, Bentonite, or Mix

LOG DATA

TYPE OF LOG RUN (Circle One): (No Log Run,) Electric, Gamma Ray, Density, Sonic, Neutron, Other (Describe)

Name of Organization Running Log

GEOLOGIC DATA (Office Use Only)

Surface Elev.	Geologic Unit	Unit Thickness	Depth to Top
Subs. SWL	Date	Analysis	Aquifer Test

SCREEN DATA

Diameter - Inches	Length - Feet	Slot Size - Inches
4"	10'	.010

Screen Type	Depth to Bottom - Feet
Slotted PVC	160

Driller's Remarks

RECEIVED
MAR 0 8 1996
Dept. of Environmental Quality
Office of Land & Water Resources

DESCRIPTION OF FORMATIONS ENCOUNTERED	FROM	TO
Red Clay	0	10
" sand	10	20
" " & Rocks	20	40
Brown Clay	40	60
	60	100
Rock	100	101
Red Clay & Sand	101	115
Rock	115	116
Gray Clay	116	130
Rock	130	131
Brown sand	131	160

FORMATIONS (Continued)	FROM	TO

IF MORE SPACE IS NEEDED, USE BACK

If well telescopes please sketch and show depths.

GROUND LEVEL

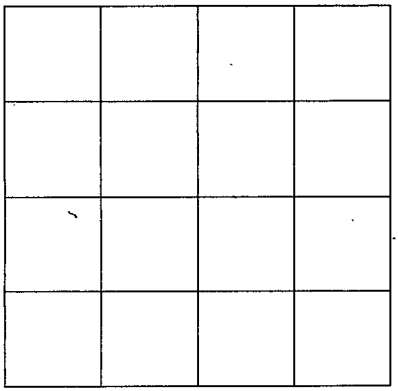

SECTION _____

Please indicate well location X.

ADDITIONAL INFORMATION

If more than one screen, show location of each on sketch.