Tishomingo
L 18
4-15-69
U.S.G.S.

MISSISSIPPI
BOARD OF WATER COMMISSIONERS
416 North State Street
Jackson, Mississippi 39201

WATER WELL DRILLERS LOG

CODED

April 15 1969 J. W. Webb & Sons Tishomingo Co
date well completed — firm name — county well located

LANDOWNER: Town of Belmont

Belmont Miss
(mailing address)

WELL LOCATION: SW/4-SW/4-SE/4
sec. 35 T 6S N/S R 10 E/W

0 miles (distance) ____ (direction) of Belmont (nearest town)

WELL PURPOSE:
(home, irrigation, municipal, industrial)

WELL COMPLETION DATA:

(1) diameter (inches) 10" over 6"

(2) total depth (feet) 200

(3) static water level (feet) 4.5 below/above top of ground.

(4) casing Steel (material), 90 ft (depth),
____ (size) if telescope see back.

(5) screen 6" 50 ft (length), 80 ft (depth to top)
6" (size), Stainless Steel (material)

(6) pump ____ (HP) ____ (yield gpm)
____ (type power)

(7) electric log yes (yes or no)
U S G S
(organization running log)

(8) how well bottom plugged Back reach plug

DRILLERS REMARKS:

description of formations encountered	from	to
Soil	0	17
Sand & Clay	17	64
Dirty Red Sand	64	85
Gravel & Sand	85	160
Sand	160	200

CODED

APR 22 1969
MISS. BD. OF WATER COMM.

(X)

If well telescopes please sketch and show depths.

GROUND LEVEL

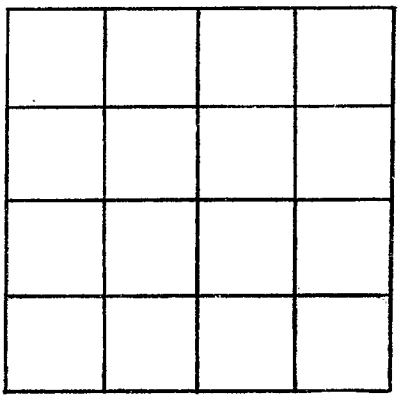

SECTION 35

Please indicate well location X.

ADDITIONAL INFORMATION

If more than one screen, show locations of each on sketch.