

Union
A 7
4-22-70

MISSISSIPPI
BOARD OF WATER COMMISSIONERS
416 North State Street
Jackson, Mississippi 39201

WATER WELL DRILLERS LOG

CODED
UNION

4-22-1970 date well completed
J T Medina firm name
UNION county well located

LANDOWNER: Carl Garner
H.W. 78 New Albany
Miss
(mailing address)

WELL LOCATION:
sec. 6 T. 6 N. R. 1 E 216
4 miles west of Myrtle
(distance) (direction) (nearest town)

WELL PURPOSE:
(home, irrigation, municipal, industrial)

WELL COMPLETION DATA:
(1) diameter (inches) 4
(2) total depth (feet) 570
(3) static water level (feet) 135 above top of ground.
(4) casing P 198 (material) (depth)
(size) if telescope see back.
(5) screen (length) (depth to top)
(size) (material)
(6) pump 2 6 (HP) (yield gpm)
(type power)
(7) electric log (yes or no)
(organization running log)
(8) how well bottom plugged

description of formations encountered	from	to
White clay	0	18
Blue sand	18	37
Yellow sand	37	39
Blue sand	39	70
" Sand + Clay	70	136
Rock	136	435
Rock	435	451
Sand	451	462
Blue	462	482
Rock	482	487
Sand	487	493
Rock	493	302
Sand	302	511
Rock	511	513
sand	513	527
Blue	527	542
Rock	542	548
Sand	548	560
Blue	560	570

CODED


MAY 5 1970

DRILLERS REMARKS: Open

MISS. RD. OR
WATER CONTROL

If well telescopes please sketch and show depths.

GROUND LEVEL

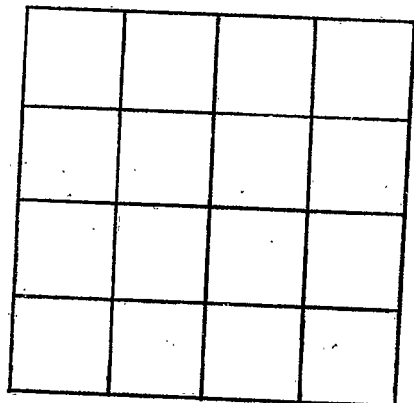

SECTION _____

Please indicate well location X.

ADDITIONAL INFORMATION

If more than one screen,
show locations of each on sketch.