UNION
B
2026

MISSISSIPPI DEPARTMENT OF NATURAL RESOURCES

Bureau of Land and Water Resources
Southport Mall
P.O. Box 10631
Jackson, Mississippi 39209

WATER WELL DRILLERS LOG

7.20.87 19 — date well completed
Medlin Well Drilling — firm name
Union — county well located

LANDOWNER:
Joseph Newton
New Albany, MS. 38652
(mailing address)

WELL LOCATION:
sec. 22 T. 6 N (S) R 2 E (W)
3 (distance) miles SW (direction) of N.A. (nearest town)

WELL PURPOSE:
(home, irrigation, municipal, industrial)

WELL COMPLETION DATA:
(1) diameter (inches) 4"
(2) total depth (feet) 300'
(3) static water level (feet) 240 below above top of ground.
(4) casing PVC (material), 160' (depth),
(size) if telescope see back.
(5) screen (length), (depth to top)
(size), (material)
(6) pump 1/2 (HP) 10 (yield gpm)
Electric (type power)
(7) electric log (yes or no)
(organization running log)
(8) how well bottom plugged

DRILLERS REMARKS:

description of formations encountered	from	to
Sand & Rock	0	70
Rock & Blue Clay	70	240
Rock & Aquafier	240	300

RECEIVED
SEP 28 1989
Department of Natural Resources
Bureau of Land & Water Resources

If well telescopes please sketch and show depths.

GROUND LEVEL

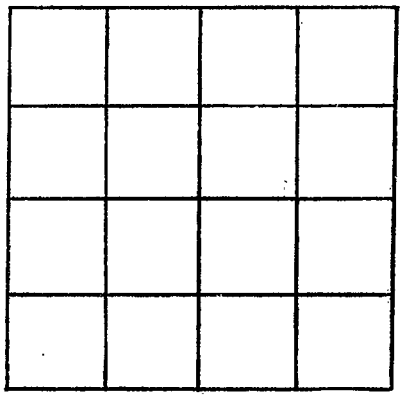

SECTION _____

Please indicate well location X.

ADDITIONAL INFORMATION

If more than one screen, show locations of each on sketch.