MISSISSIPPI DEPARTMENT OF ENVIRONMENTAL QUALITY
Office of Land and Water Resources

P. O. Box 10631
Jackson, MS 39289-0631
WATER WELL DRILLERS LOG

COUNTY WELL LOCATED: Union	
WELL NUMBER: F	CODED:
2024	
DATE WELL COMPLETED: April 1994	
PERMIT NUMBER:	
NAME OF DRILLING FIRM: Leeper Drilling	
Pontotoc	

NAME & MAILING ADDRESS OF LANDOWNER
Brian Waddell
Pinedale Community
New Albany MS

WELL LOCATION: SEC 27 TOWNSHIP 7 N (S) RANGE 1 (E) W

DISTANCE ____ Miles DIRECTION ____ of NEAREST TOWN ____

OTHER LANDMARK: Lower Road @ Pinedale

WELL PURPOSE: Home, Irrigation, Municipal, Industrial, Fish Pond, etc.
Home

PUMP DATA

PUMP TYPE (Circle One): (Submersible,) Turbine, Jet Flowing Well, Other (Describe) ____

POWER TYPE (Circle One): (Electric,) Tractor, Diesel, Gasoline, Butane, Other (Describe) ____ H/P ____

Pump Capacity (GPM)	No. of Stages	Setting Depth
10	11	100 FT.

PUMP TEST

Well yielded ____ GPM with

a drawdown of ____ ft.

after ____ hours of pumping

WELL DATA

Well Depth	Casing Diameter (In.)	Casing Length (Ft.)
430'	4"	200'

Type of Casing	Hole Depth	Depth to Static Water Level
PVC	430'	70'

TYPE OF COMPLETION: (Circle One or More): Gravel Packed, Underreamed, (Telescoped,) Natural Development, Open Hole, Other (Describe) ____

WELL GROUTED TO A DEPTH OF 10 FEET
Type Grout (circle one): Cement, (Bentonite, or Mix)

LOG DATA

TYPE OF LOG RUN (Circle One): No Log Run, Electric, Gamma Ray, Density, Sonic, Neutron, Other (Describe) ____

Name of Organization Running Log

GEOLOGIC DATA (Office Use Only)

Surface Elev.	Geologic Unit	Unit Thickness	Depth to Top
Subs. SWL	Date	Analysis	Aquifer Test

Driller's Remarks
4" x 2" Wall

SCREEN DATA

Diameter - Inches	Length - Feet	Slot Size - Inches
2"	40'	.010

Screen Type	Depth to Bottom - Feet
Slotted PVC	430'

DESCRIPTION OF FORMATIONS ENCOUNTERED	FROM	TO	FORMATIONS (Continued)	FROM	TO
Top Clay	0	20			
Blue Clay	20	250			
Chalk	250	380			
Sand	380	430			
			IF MORE SPACE IS NEEDED, USE BACK		

RECEIVED
DEC 1 1 1995
Dept. of Environmental Quality
Office of Land & Water Resources

If well telescopes please
sketch and show depths.

GROUND LEVEL

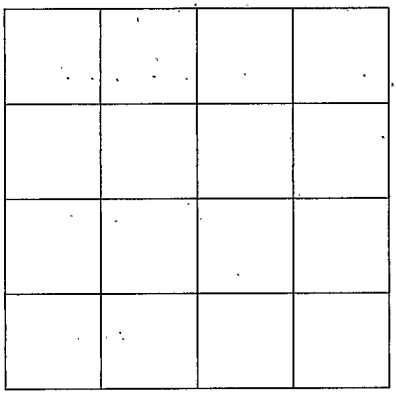

SECTION _____

Please indicate well location X.

ADDITIONAL INFORMATION

If more than one screen,
show location of each on sketch.