UNION
G39
12-15-71

MISSISSIPPI
BOARD OF WATER COMMISSIONERS
416 North State Street
Jackson, Mississippi 39201

Net 650.00
3250
$1682 50

WATER WELL DRILLERS LOG

CODED

12-15 — 19 71 — F. Medlin
date well completed — firm name — county well located

LANDOWNER: Curtis Haynes
New Albany
Miss
(mailing address)

WELL LOCATION:
sec 36 T 7 N (S) R 2 (E) W
3 (distance) miles N (direction) of Ingomar (nearest town)

WELL PURPOSE:
(home, irrigation, municipal, industrial)

WELL COMPLETION DATA:

(1) diameter (inches) 4
(2) total depth (feet) 231
(3) static water level (feet) 32 below (above) top of ground.
(4) casing P (material), 80 (depth),
(size) if telescope see back.
(5) screen (length), (depth to top)
(size), (material)
(6) pump ½ (HP) (yield gpm)
E (type power)
(7) electric log (yes or no)
(organization running log)
(8) how well bottom plugged open

DRILLERS REMARKS:

description of formations encountered	from	to
Clay	0	23
Rock & Clay	23	60
Blue "	60	160
Rock & Sand	160	231

CODED

JAN 5 1972
MISS. BD. OF
WATER COMM.

If well telescopes please sketch and show depths.

GROUND LEVEL

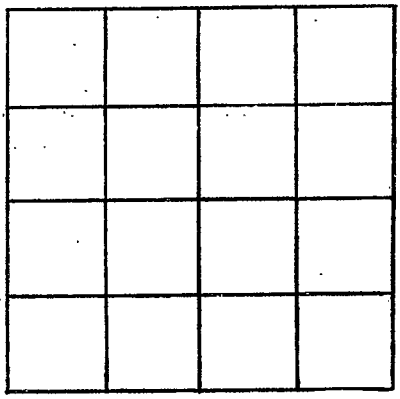

SECTION _____

Please indicate well location X.

ADDITIONAL INFORMATION

If more than one screen, show locations of each on sketch.