

G 42

5-22-62

WATER WELL DRILLERS LOG

CODED

Date: 5-22, 1942 Driller: C. F. CARLIS County: UNION
 (Name)

(1) Owner of Land: FRED SCHUMAN
 (Name)
NEW ALBANY MISS
 (Address)

(2) Location: 1/4, 1/4, Sec. 2 T 7 R 2
4 miles WEST, of IVA
 (distance) (direction) (Nearest Town)

(3) Topography: 1
 (Hilly) (Flat) (Level)

(4) Purpose of Well: DOMESTIC
 (Domestic Irrigation
 Municipal, Industrial, Other)

| Description & Color of Materials Sand, Clay, Red Clay, Shell, etc. | Thick- ness Feet | Depth Feet |
|---|------------------------|---------------|
| SOAPSTONE | 25 | 26 |
| BLUE DIRT | 40 | 43 |
| ROCK SAND | 36 | 100 |
| BLUE DIRT | 40 | 140 |
| W-ROCK | 10 | 150 |
| W-SAND | 40 | 190 |

Information upon completion of well:

(1) Diameter 4 inches.

(2) Total Depth 190 feet.

(3) Water Level 40 feet below top of ground.

(4) Cased to 43, Size _____.

(5) Screen: Size _____, Length _____.


(6) Were any formations sealed against pollution?
 _____ yes, _____ no.

CODED

If YES depth of formation _____

Why _____

Drillers Remarks: _____

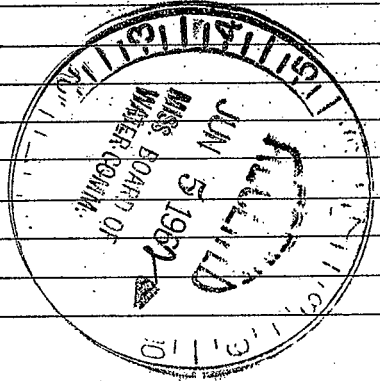

Well No. 31

(Use Back Side)






