UNION
G55 CODED
7-1-72

MISSISSIPPI
BOARD OF WATER COMMISSIONERS
416 North State Street
Jackson, Mississippi 39201

600.00 For well
30.00 tax
30.00

WATER WELL DRILLERS LOG

7-1-72 19 — J. Medlin — UNION
date well completed — firm name — county well located

LANDOWNER: Joe Farrow

New Albany
(mailing address)

WELL LOCATION:
sec. 12 T 7 N (S) R 2 (E)
2 mi miles West of New Albany
(distance) (direction) (nearest town)

WELL PURPOSE:
(home, irrigation, municipal, industrial)

WELL COMPLETION DATA:

(1) diameter (inches) 4"

(2) total depth (feet) 180

(3) static water level (feet) 30 below above top of ground.

(4) casing Plastic, 60'
(material), (depth),
(size) if telescope see back.

(5) screen 0, (length), (depth to top)
(size), (material)

(6) pump 3/4 (HP) 6 (yield gpm)
electric (type power)

(7) electric log (yes or no)
(organization running log)

(8) how well bottom plugged

DRILLERS REMARKS:

description of formations encountered	from	to
Clay	0	12
Rock & Clay	12	50
Blue Clay	50	130
Rock + Salt	130	180

AUG 22 1972
MISS. DRA
WATER

If well telescopes please sketch and show depths.

GROUND LEVEL

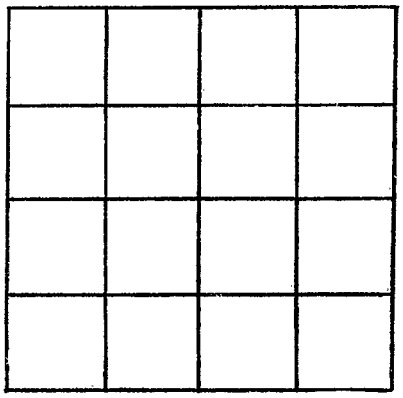

SECTION _____

Please indicate well location X.

ADDITIONAL INFORMATION

If more than one screen, show locations of each on sketch.