Union Co.
673
Page #2

MISSISSIPPI DEPARTMENT OF NATURAL RESOURCES
Bureau of Land and Water Resources
Southport Mall
P.O. Box 10631
Jackson, Mississippi 39209

Page 2

WATER WELL DRILLERS LOG

19 9 Hwy 30 W.A. % Bud McNeal (President)
date well completed — firm name — county well located
109 E. Bankhead — Union Co.

LANDOWNER: new allow

(mailing address)

WELL LOCATION:

sec. ___ T ___ N/S R ___ E/W

___ miles ___ of ___
(distance) (direction) (nearest town)

WELL PURPOSE:
(home, irrigation, municipal, industrial)

WELL COMPLETION DATA:

(1) diameter (inches) ___

(2) total depth (feet) ___

(3) static water level (feet) ___ below/above top of ground.

(4) casing ___ (material), ___ (depth),
___ (size) if telescope see back.

(5) screen ___ (length), ___ (depth to top)
___ (size), ___ (material)

(6) pump ___ (HP) ___ (yield gpm)
___ (type power)

(7) electric log ___ (yes or no)
___ (organization running log)

(8) how well bottom plugged ___

DRILLERS REMARKS: ___

description of formations encountered	from	to
Rock	1129	1131
Sandy Clay	1131	1144
Hard Sandy Clay	1144	1179
Rock	1179	1181
Brickley Sandy Clay	1181	1231
Fine Sand & Clay stks ½ & ½	1231	1316
Sandy Clay	1316	1329
Rock & Sand Clay stks.	1329	1367

DEPT. OF NATURAL RESOURCES
BUREAU OF LAND & WATER RESOURCES
OCT 4 1983
RECEIVED

If well telescopes please sketch and show depths.

GROUND LEVEL

If more than one screen, show locations of each on sketch.

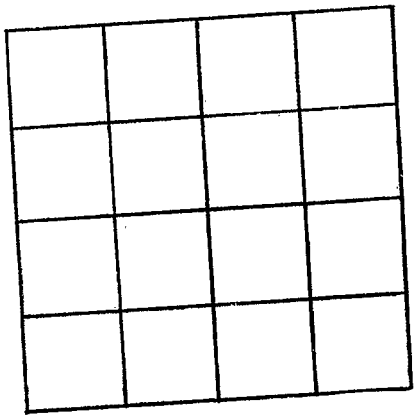

SECTION _____

Please indicate well location X.

ADDITIONAL INFORMATION