
state M	All Deport		
County: NiON State Well Report Part 1		For Office Use Only:	
County: Part 1 Mississippi Department of Environmental Quality		Aquifer:	
Permit #: Office of Land a	and Water Resources	Well #: 6-85	
Driller: Leeper Drilling P.O. Box 10631			
Date drilling completed: <u>9-26-05</u> Jackson, MS 39289-0631 (601)961-5210		L. S. Elevation:	
(601)354-6938 (fax)		E-log #:	
State Law requires that this report be prepared by the driller in detail and filed with the Department within 30 days of completion of drilling of the well.			
Well-Owner Information Well Location		Location	
Owner Name Webb	Latitude:°'	" Longitude:'	
Mailing Address: <u><u>5021 Poplar</u> Method of Lat/Long (circle or</u>		e): Conventional Survey,	
		GPS, Survey-grade GPS	
14			
Distance Direction		Nearest Town of <u>New Alban</u> y	
Well Data			
Purpose of well (circle one) Home       Industrial       Public Supply       Irrigation       Fish Culture       Other:         Date well drilling started: $\frac{9}{2}$ $\frac{23}{-05}$ Date well drilling completed: $\frac{5}{-26}$ $\frac{5}{-26}$			
If flowing, method of flow regulation: Valve Other (describe)			
Static Water Level:			
Method of Measurement (circle one) steel tape electric tape air line other:			
Hole depth: Well depth: Well grouted to a depth of feet			
Type of grout (circle one): Cement Bentonite Mix			
Casing length: $260$ feet Casing diameter: $47$ inches Type of casing: $90c$			
Screen length: <u>40</u> feet Screen diameter: <u>2</u> inches Type of screen: <u>PUC</u>			
Screen slot size: $100$ inches Setting depth: From $365$ feet to $405$ feet			
Type of completion (circle all applicable): Gravel packed Underreamed Telescoped Open hole Natural Development			
Other (describe):			
Top of lap pipe or reduction in casing:feet. If telescoped or more than one screen, describe on back of page			
Logs run (circle all applicable): No log run Electric Gamma Ray Density Sonic Neutron Other:			
Name of organization running log(s):			
I certify that the well was drilled, constructed, and completed in accordance with all applicable requirements of the Mississippi Department of Environmental Quality and/or the Mississippi Department of Health regulations and state laws.			
Leeper Drilling # 0079 63 Leeper			
Print Name of Water Well Contractor and License No. Signature of Water Well Contractor			
		RECEIVED	
DC3 (1 2005			
		BY: OLWR	

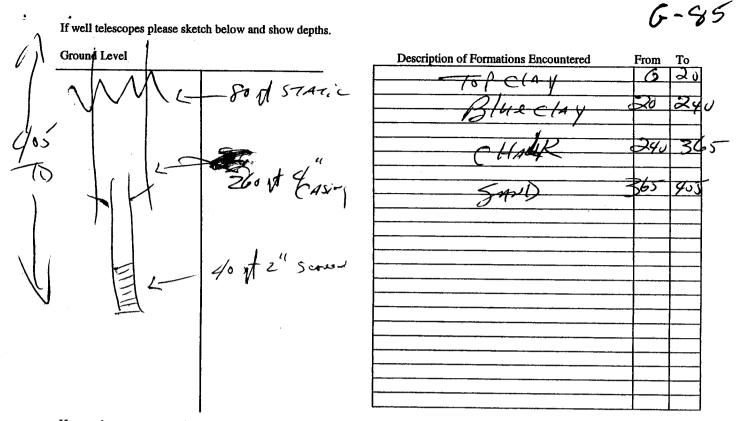

If more than one screen, show location of each on sketch

Sketch the property layout and include the following: 1) the well location; 2) any permanent structures on the property that may aid in locating the well; 3) any roads, power lines, or other items that may aid in locating the property and the well; 4) indicate direction. HOME i well Kobert Webb Landowner Name: Signature of Water Well Contractor RECEIVED

0CT 17 2005 BY: OLWF

STATE WELL REPORT		
County: $MioN$ Pump InstallerPermit #: $Mississippi DepartmentDriller:eeperprillingDate completed:9/27/as(601)32$	Part 2       For Office Use Only:         is Completion Report       Aquifer:         and Water Resources       Aquifer:         Box 10631       Well #:         VIS 39289-0631       Elevation:         961-5210       Elevation:	
This report should be prepared by the pump installer in detail and filed with the Department within 30 days of the installation of pump. Well-Qwner Information		
Owner Name: Kober T Webb	Well Location	
Mailing Address: <u>5021</u> Poplar <u>Memphin</u> Ton 38157 City State Zip Code Telephone No. ( <u>fo1</u> ) 626-3629	Latitude:       Longitude:         Method of Lat/Long (circle one): Conventional Survey,         USGS quad, Hand-held GPS, Survey-grade GPS        4       4 Sec6Twn_7 SRng2E         Distance       Direction       Nearest Town        6 Miles       West_ofNead_Afbaar_y	
Pump Type       Circle one       Air Lift       Jet       Submersible	Power Type Circle one Diesel Engine Gasoline Engine Natural Gas	
Bucket Piston Turbine		
Centrifugal Rotary Flowing Well	Electric Motor         Hand         Tractor PTO           Windmill         Other (specify):	
Other (specify):	Windmill       Other (specify):         Horse Power Rating of Motor:       3/4       HP         Setting Depth:       140       feet         Number of Stages:       14       140	
Pump Test Data         Date Well Tested:       9 27-05         Static Water Level (A):       Feet/Below Land Surface	Method of Measuring Water Level Circle one Air Line Electric Measuring Line Steel Tape	
Pumping Water Level (B):Feet Below Land Surface	Other (specify):	
Drawdown [(B) – (A)]:Feet Below Land Surface	For flowing well, measured shut in head:feet	
Test Pumping Rate:Gallons Per Minute	Well yieldedGPM with a drawdown of	
Duration of Pump Test (minimum 4 hours):hours	feet afterhours of pumping	
I HEREBY CERTIFY that the above statements are true to the best of my knowledge. <u>LEEPER</u> )		

.

0CT 17 2005 BY: OLWR