Union
G
2023

MISSISSIPPI DEPARTMENT OF NATURAL RESOURCES
Bureau of Land and Water Resources
Southport Mall
P.O. Box 10631
Jackson, Mississippi 39209
WATER WELL DRILLERS LOG

5·12·86 date well completed — 19 Medlin Water Well firm name — Union county well located

LANDOWNER: Alvin Wilson
247 Chestnut
Beloit, Wisconsin 53511
(mailing address)

WELL LOCATION:
sec. 2 T 7 N (S) R 2 (E) W
4 (distance) miles S/W (direction) of New Albany (nearest town)

WELL PURPOSE:
2nd (home, irrigation, municipal, industrial)

WELL COMPLETION DATA:
(1) diameter (inches) 4"
(2) total depth (feet) 320"
(3) static water level (feet) 160 below above top of ground.
(4) casing PVC (material), 210 (depth), ____ (size) if telescope see back.
(5) screen ____ (length), ____ (depth to top), ____ (size), ____ (material)
(6) pump 1/2 (HP) 11 (yield gpm) Electric (type power)
(7) electric log ____ (yes or no)
____ (organization running log)
(8) how well bottom plugged ____

DRILLERS REMARKS: ____

description of formations encountered	from	to
Top Soil & Sand	0	90
Sand & Clay	90	200
Rock	200	210
Aquafir	210	320

RECEIVED
JUN 27 1986
Department of Natural Resources
Bureau of Land & Water Resources

If well telescopes please sketch and show depths.

GROUND LEVEL

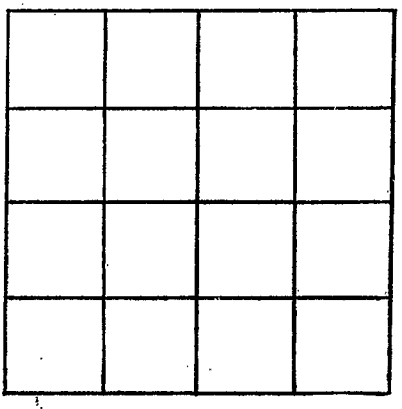

SECTION _____

Please indicate well location X.

ADDITIONAL INFORMATION

If more than one screen, show locations of each on sketch.