UNION
H 54
5-11-72

MISSISSIPPI
BOARD OF WATER COMMISSIONERS
416 North State Street
Jackson, Mississippi 39201

WATER WELL DRILLERS LOG CODED

May 11 1972 J. W. Webb & Sons Union
date well completed firm name county well located

LANDOWNER: Marvin Davis

Ingomar Miss
(mailing address)

WELL LOCATION:
sec. 31 T 7 N (S) R 3 (E) W

1 miles North of Ingomar
(distance) (direction) (nearest town)

WELL PURPOSE:
(home, irrigation, municipal, industrial)

WELL COMPLETION DATA:

(1) diameter (inches) 4"

(2) total depth (feet) 210

(3) static water level (feet) 84 below above top of ground.

(4) casing Steel (material), 63 ft (depth),
4" (size) if telescope see back.

(5) screen 0 (length), 0 (depth to top)
0 (size), 0 (material)

(6) pump No Pump (HP) (yield gpm)

(type power)

(7) electric log (yes or no)

(organization running log)

(8) how well bottom plugged

DRILLERS REMARKS:

description of formations encountered	from	to
Soil	0	1
Red Sand & Clay	1	60
Blue Rock	60	111
Water Rock	111	114
Water Sand & Rocks	114	210
Ripley Sand		

CODED

MAR 10 1977
MISS. BD. OF WATER COMM.

If well telescopes please sketch and show depths.

GROUND LEVEL

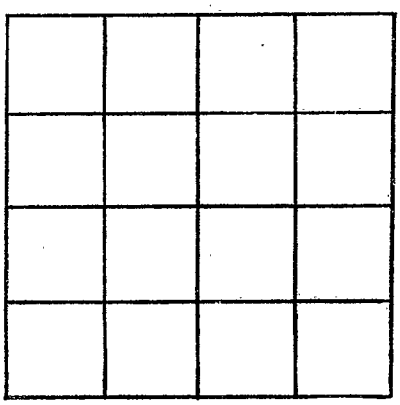

SECTION _____

Please indicate well location X.

ADDITIONAL INFORMATION

If more than one screen, show locations of each on sketch.