UNION
J 2007
5-11-81

MISSISSIPPI
BOARD OF WATER COMMISSIONERS
416 North State Street
Jackson, Mississippi 39201

WATER WELL DRILLERS LOG

May 11 19 81 J. WEBB'S SONS UNION
date well completed — firm name — county well located

LANDOWNER: J. J. W. FARMS

ELLISTOWN, MISS
(mailing address)

WELL LOCATION:
sec 32 T 7 ~~N~~ S R 5 E ~~W~~

2 miles S. E. of ELLISTOWN
(distance) (direction) (nearest town)

WELL PURPOSE: HOME
(home, irrigation, municipal, industrial)

WELL COMPLETION DATA:

(1) diameter (inches) 7"

(2) total depth (feet) 340'

(3) static water level (feet) 60 below ~~above~~ top of ground.

(4) casing STEEL (material), 20' (depth),
(size) if telescope see back.

(5) screen (length), (depth to top)
(size), (material)

(6) pump 1 (HP) 12 (yield gpm)
ELECTRIC (type power)

(7) electric log NO (yes or no)
(organization running log)

(8) how well bottom plugged

DRILLERS REMARKS:

description of formations encountered	from	to
CLAY	0	12
BLUE CLAY	12	190
SAND	190	325
SANDY CLAY	325	340

DEPT. OF NATURAL RESOURCES
BUREAU OF LAND & WATER RESOURCES
JUN 15 1981
RECEIVED

If well telescopes please sketch and show depths.

GROUND LEVEL

If more than one screen, show locations of each on sketch.

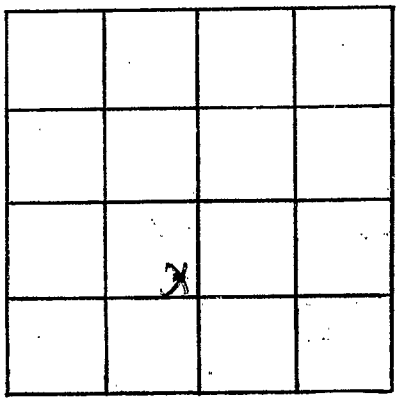

SECTION 32

Please indicate well location X.

ADDITIONAL INFORMATION