Union
K 2046

MISSISSIPPI DEPARTMENT OF NATURAL RESOURCES

Bureau of Land and Water Resources
Southport Mall
P.O. Box 10631
Jackson, Mississippi 39209

WATER WELL DRILLERS LOG

6-19 1984 Medlin Well Co. Union
date well completed — firm name — county well located

LANDOWNER: Mike Pannell
Pineedale, MS.
(mailing address)

WELL LOCATION:
sec. 1 T 8 N (S) R 1 (E) W
9 miles SW of New Albany
(distance) (direction) (nearest town)

WELL PURPOSE:
(home, irrigation, municipal, industrial)

WELL COMPLETION DATA:

(1) diameter (inches) 4"
(2) total depth (feet) 580'
(3) static water level (feet) 90' below above top of ground.
(4) casing PVC (material), 120' (depth),
(size) if telescope see back.
(5) screen (length), (depth to top)
(size), (material)
(6) pump 1/2 (HP) 11 (yield gpm)
Elec. (type power)
(7) electric log (yes or no)
(organization running log)
(8) how well bottom plugged

DRILLERS REMARKS:

description of formations encountered	from	to
Top Soil	0	60
Limerock & clay	60	112
Clay	112	120
Clay & Limestone	120	290
Clay & Limestone	290	450
Aquifer	450	580

RECEIVED
MAR 3 - 1986
Department of Natural Resources
Bureau of Land & Water Resources

If well telescopes please sketch and show depths.

GROUND LEVEL

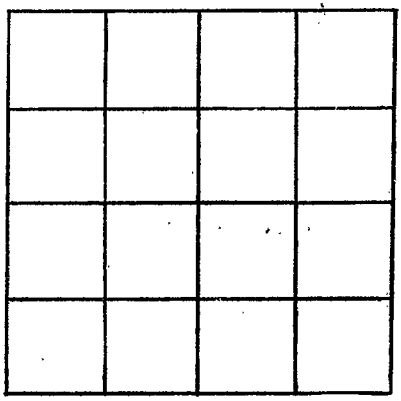

SECTION _____

Please indicate well location X.

ADDITIONAL INFORMATION

If more than one screen, show locations of each on sketch.