MISSISSIPPI DEPARTMENT OF ENVIRONMENTAL QUALITY
Office of Land and Water Resources

P. O. Box 10631
Jackson, MS 39289-0631
WATER WELL DRILLERS LOG

COUNTY WELL LOCATED	Union
WELL NUMBER	K
CODED	
	2040
DATE WELL COMPLETED	April 1994
PERMIT NUMBER	
NAME OF DRILLING FIRM	Leeper Drilling
	Pontotoc

NAME & MAILING ADDRESS OF LANDOWNER
Thomas Scott
Pinedale Community
New Albany, MS

WELL LOCATION: SEC 2 TOWNSHIP 8 N (S) RANGE 1 (E) W

DISTANCE ____ Miles DIRECTION ____ of NEAREST TOWN ____

OTHER LANDMARK: Lower Road @ Pinedale

WELL PURPOSE: Home, Irrigation, Municipal, Industrial, Fish Pond, etc.
Home

PUMP DATA

PUMP TYPE (Circle One): (Submersible,) Turbine, Jet Flowing Well, Other (Describe) ____

POWER TYPE (Circle One): (Electric,) Tractor, Diesel, Gasoline, Butane, Other (Describe) ____ H/P ____

Pump Capacity (GPM)	No. of Stages	Setting Depth
10	11	100 FT.

PUMP TEST
Well yielded ____ GPM with
a drawdown of ____ ft.
after ____ hours of pumping

WELL DATA

Well Depth	Casing Diameter (In.)	Casing Length (Ft.)
400	4"	200'
Type of Casing	**Hole Depth**	**Depth to Static Water Level**
PVC	400'	60'

TYPE OF COMPLETION: (Circle One or More): Gravel Packed, Underreamed, (Telescoped,) Natural Development, Open Hole, Other (Describe) ____

WELL GROUTED TO A DEPTH OF 10 FEET
Type Grout (circle one): Cement, (Bentonite, or Mix)

LOG DATA

TYPE OF LOG RUN (Circle One): No Log Run, Electric, Gamma Ray, Density, Sonic, Neutron, Other (Describe) ____

Name of Organization Running Log

GEOLOGIC DATA (Office Use Only)

Surface Elev.	Geologic Unit	Unit Thickness	Depth to Top
Subs. SWL	Date	Analysis	Aquifer Test

Driller's Remarks
4" x 2" Well

SCREEN DATA

Diameter - Inches	Length - Feet	Slot Size - Inches
2"	30'	.010
Screen Type	**Depth to Bottom - Feet**	
Slotted PVC	400'	

DESCRIPTION OF FORMATIONS ENCOUNTERED	FROM	TO
Top Clay	0	20
Blue Clay	20	250
Chack	250	340
Sand	340	400

FORMATIONS (Continued)	FROM	TO

IF MORE SPACE IS NEEDED, USE BACK

RECEIVED
DEC 11 1995
Dept. of Environmental Quality
Office of Land & Water Resources

If well telescopes please
sketch and show depths.

GROUND LEVEL

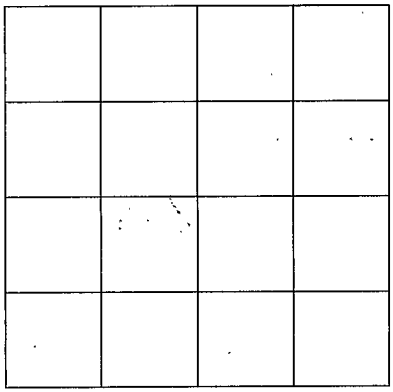

SECTION _____

Please indicate well location X.

ADDITIONAL INFORMATION

If more than one screen,
show location of each on sketch.