MISSISSIPPI DEPARTMENT OF ENVIRONMENTAL QUALITY
Office of Land and Water Resources

P. O. Box 10631
Jackson, MS 39289-0631

WATER WELL DRILLERS LOG

COUNTY WELL LOCATED	UNION
WELL NUMBER	R
CODED	
DATE WELL COMPLETED	Jan 1995
PERMIT NUMBER	
NAME OF DRILLING FIRM	CEEPER Drilling Pontotoc

NAME & MAILING ADDRESS OF LANDOWNER: Don Gates, Rt 1, ETTA MS

WELL LOCATION: SEC 9 TOWNSHIP 8 (N/S) RANGE 1 (E/W)

DISTANCE 12 Miles DIRECTION SW NEAREST TOWN of NEW Albany

OTHER LANDMARK: Pinedale Area

WELL PURPOSE: Home, Irrigation, Municipal, Industrial, Fish Pond, etc.: Home

PUMP DATA

PUMP TYPE (Circle One): Submersible, Turbine, Jet, Flowing Well, Other (Describe)

POWER TYPE (Circle One): Electric, Tractor, Diesel, Gasoline, Butane, Other (Describe) McCLEAR H/P 3/4

Pump Capacity (GPM)	No. of Stages	Setting Depth
10	11	200' FT.

PUMP TEST

Well yielded _____ GPM with a drawdown of _____ ft. after _____ hours of pumping

WELL DATA

Well Depth	Casing Diameter (In.)	Casing Length (Ft.)
540'	4"	260'

Type of Casing	Hole Depth	Depth to Static Water Level
PVC	540'	140'

TYPE OF COMPLETION: (Circle One or More): Gravel Packed, Underreamed, Telescoped, Natural Development, Open Hole, Other (Describe)

WELL GROUTED TO A DEPTH OF 10 FEET
Type Grout (circle one): Cement, Bentonite, or Mix

LOG DATA

TYPE OF LOG RUN (Circle One): No Log Run, Electric, Gamma Ray, Density, Sonic, Neutron, Other (Describe)

Name of Organization Running Log

GEOLOGIC DATA (Office Use Only)

Surface Elev.	Geologic Unit	Unit Thickness	Depth to Top
Subs. SWL	Date	Analysis	Aquifer Test

Driller's Remarks

Top of Lap-Pipe or Reduction in Casing FEET — IF TELESCOPED OR MORE THAN ONE SCREEN: USE BACK PAGE

SCREEN DATA

Diameter - Inches	Length - Feet	Slot Size - Inches
2"	40'	.010

Screen Type	Depth to Bottom - Feet
Slotted PVC	540'

DESCRIPTION OF FORMATIONS ENCOUNTERED	FROM	TO
Top Clay	0	20
Blue Clay	20	200
CHALK	200	500
SAND	500	540

FORMATIONS (Continued)	FROM	TO

IF MORE SPACE IS NEEDED, USE BACK

RECEIVED DEC 11 1995 Dept. of Environmental Quality Office of Land & Water Resources

If well telescopes please sketch and show depths.

GROUND LEVEL

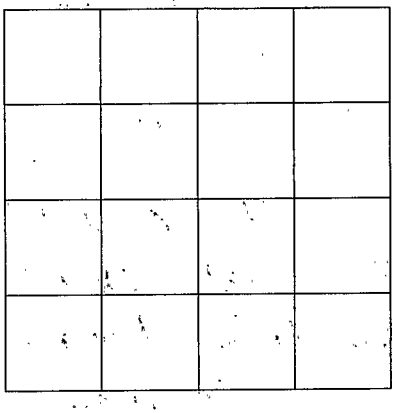

SECTION _____

Please indicate well location X.

ADDITIONAL INFORMATION

If more than one screen, show location of each on sketch.