UNION
N 2000
4-16-76

13C

MISSISSIPPI
BOARD OF WATER COMMISSIONERS
416 North State Street
Jackson, Mississippi 39201

WATER WELL DRILLERS LOG

4-16 1976 J.W. Webb & Sons Union
date well completed — firm name — county well located

LANDOWNER: Murphy Daniel
Blue Springs
(mailing address)

WELL LOCATION:
sec. 12 T. 8S N/S R. 4 E/W
3 miles N. East of Sherman
(distance) (direction) (nearest town)

WELL PURPOSE:
(home, irrigation, municipal, industrial)

WELL COMPLETION DATA:
(1) diameter (inches) 5
(2) total depth (feet) 430
(3) static water level (feet) 188 below/above top of ground.
(4) casing Steel (material), 42 (depth),
0 (size) if telescope see back.
(5) screen 0 (length), 0 (depth to top)
(size), (material)
(6) pump 1/2 HP Sub (HP) 8 (yield gpm)
Elec (type power)
(7) electric log no (yes or no)
(organization running log)
(8) how well bottom plugged open

DRILLERS REMARKS:

description of formations encountered	from	to
Soil	0	1
Humbo + Clay	1	34
Blue Rock	34	330
Water Rock	330	331
Water Sand	331	430
Coffee Sand		

JUN 24 1976
MISS. BD. OF WATER COMM.

If well telescopes please sketch and show depths.

GROUND LEVEL

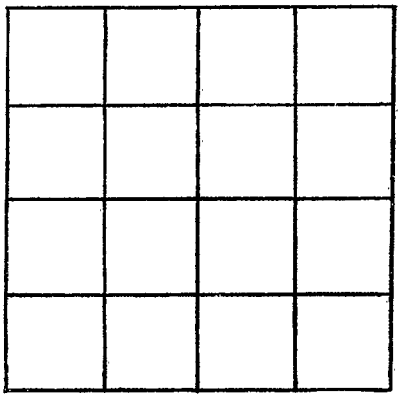

SECTION _____

Please indicate well location X.

ADDITIONAL INFORMATION

If more than one screen, show locations of each on sketch.