WALTHALL

A 73

5-18-72

MISSISSIPPI
BOARD OF WATER COMMISSIONERS
416 North State Street
Jackson, Mississippi 39201

WATER WELL DRILLERS LOG

CODE WALTHALL

May 18 1972 — date well completed

Grenn Water Well Contr. — firm name

county well located

LANDOWNER: Larry Rayborn

Rt. 1,

Mayess, Miss.

(mailing address)

WELL LOCATION:

sec. 18 T 4 N S R 10 E W

16 (distance) miles E (direction) of McComb (nearest town)

WELL PURPOSE: home (home, irrigation, municipal, industrial)

WELL COMPLETION DATA:

(1) diameter (inches) 6"

(2) total depth (feet) 175'

(3) static water level (feet) 80' below above top of ground.

(4) casing PVC (material), 160' (depth), 4" (size) if telescope see back.

(5) screen 6' (length), 160' (depth to top), .010 (size), PVC (material)

(6) pump did not install (HP) (yield gpm)

(type power)

(7) electric log no (yes or no)

(organization running log)

(8) how well bottom plugged wood

DRILLERS REMARKS:

description of formations encountered	from	to
red sand, clay & gravel	0	175

CODED

MAY 30 1972

MISS. BD. OF WATER COMM.

If well telescopes please sketch and show depths.

GROUND LEVEL

If more than one screen, show locations of each on sketch.

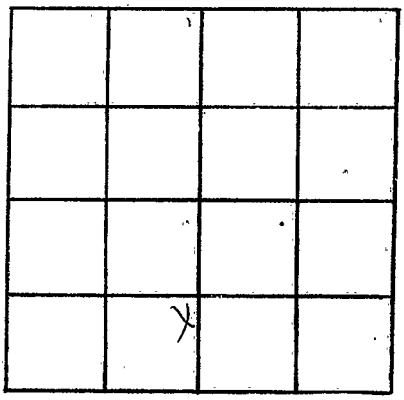

SECTION 18

Please indicate well location X.

ADDITIONAL INFORMATION