MISSISSIPPI DEPARTMENT OF NATURAL RESOURCES

Bureau of Land and Water Resources

P.O. Box 10631
Jackson, Mississippi 39209
WATER WELL DRILLERS LOG

COUNTY WELL LOCATED: Wallthall	
WELL NUMBER: B	CODED:
3042	
DATE WELL COMPLETED: March 22-90	

PERMIT NUMBER	
NAME OF DRILLING FIRM: FITZGERALD Well Sev	

NAME & MAILING ADDRESS OF LANDOWNER
Teresa Gin
R.R. Tylertown, Ms.

WELL LOCATION: SEC 26 TOWNSHIP 4 N/S RANGE 11 E/W

DISTANCE 4 Miles DIRECTION E of NEAREST TOWN MANNINGS

OTHER LANDMARK

WELL PURPOSE: Home, Irrigation, Municipal, Industrial, Fish Pond, etc.
Home

PUMP DATA

PUMP TYPE (Circle One): Submersible, Turbine, Jet Flowing Well, Other (Describe)

POWER TYPE (Circle One): Electric, Tractor, Diesel, Gasoline, Butane, Other (Describe) H/P 1/2

Pump Capacity (GPM)	No. of Stages	Setting Depth
10	9	98 FT.

PUMP TEST

Well yielded 20 GPM with a drawdown of 2 ft. after 2 hours of pumping.

WELL DATA

Well Depth	Casing Diameter (In.)	Casing Length (Ft.)
110	4	100

Type of Casing	Hole Depth	Depth to Static Water Level
PVC	110	80

TYPE OF COMPLETION: (Circle One or More): Gravel Packed, Underreamed, Telescoped, Natural Development, Open Hole, Other (Describe)

Top of Lap Pipe or Reduction in Casing FEET

IF TELESCOPED OR MORE THAN ONE SCREEN: USE BACK PAGE

LOG DATA

TYPE OF LOG RUN (Circle One): No Log Run, Electric, Gamma Ray, Density, Sonic, Neutron, Other (Describe)

Name of Organization Running Log

GEOLOGIC DATA (Office Use Only)

Surface Elev.	Geologic Unit	Unit Thickness	Depth to Top
Subs. SWL	Date	Analysis	Aquifer Test

Driller's Remarks

SCREEN DATA

Diameter - Inches	Length - Feet	Slot Size - Inches
4	10	.014

Screen Type	Depth to Bottom - Feet
PVC	110

DESCRIPTION OF FORMATIONS ENCOUNTERED	FROM	TO
Red Clay	0	20
Red Sand	20	94
Coarse Sand & gravel	94	110

FORMATIONS (Continued) FROM TO

RECEIVED
APR 06 1990
Department of Natural Resources
Bureau of Land & Water Resources

IF MORE SPACE IS NEEDED, USE BACK

If well telescopes please
sketch and show depths.

GROUND LEVEL

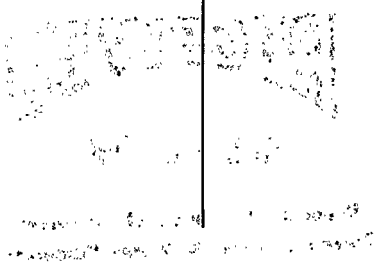

If more than one screen,
show location of each on sketch.

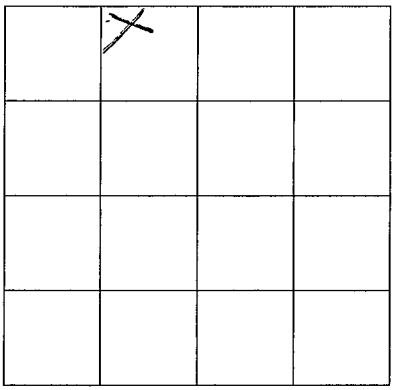

SECTION 26

Please indicate well location X.

ADDITIONAL INFORMATION