MISSISSIPPI DEPARTMENT OF ENVIRONMENTAL QUALITY
Office of Land and Water Resources

P. O. Box 10631
Jackson, MS 39289-0631
WATER WELL DRILLERS LOG

COUNTY WELL LOCATED: Walthall	
WELL NUMBER: B 206	CODED: 3
PERMIT NUMBER: 0-287	
NAME OF DRILLING FIRM: Reeves Well Ser.	
DATE WELL COMPLETED: 6-5-98	

NAME & MAILING ADDRESS OF LANDOWNER: Billy Reid

WELL LOCATION: SEC 9 TOWNSHIP 4 (N/S) RANGE 11 (E/W)

DISTANCE 12 Miles DIRECTION NE of NEAREST TOWN Tylertown

OTHER LANDMARK

WELL PURPOSE: Home, Irrigation, Municipal, Industrial, Fish Pond, etc.

PUMP DATA

PUMP TYPE (Circle One): Submersible, Turbine, Jet, Flowing Well, Other (Describe)

POWER TYPE (Circle One): Electric, Tractor, Diesel, Gasoline, Butane, Other (Describe) H/P 1

Pump Capacity (GPM)	No. of Stages	Setting Depth
19	11	90 FT.

PUMP TEST

Well yielded 50 GPM with a drawdown of 0 ft. after 1 hours of pumping

WELL DATA

Well Depth	Casing Diameter (In.)	Casing Length (Ft.)
100'	4"	90'
Type of Casing	**Hole Depth**	**Depth to Static Water Level**
PVC	100'	60'

TYPE OF COMPLETION: (Circle One or More): Gravel Packed, Underreamed, Telescoped, Natural Development, Open Hole, Other (Describe) 10 gal Sand

WELL GROUTED TO A DEPTH OF 10 FEET
Type Grout (circle one): ~~Cement~~, Bentonite, or Mix

LOG DATA

TYPE OF LOG RUN (Circle One): No Log Run, Electric, Gamma Ray, Density, Sonic, Neutron, Other (Describe)

Name of Organization Running Log

GEOLOGIC DATA (Office Use Only)

Surface Elev.	Geologic Unit	Unit Thickness	Depth to Top
Subs. SWL	Date	Analysis	Aquifer Test

Driller's Remarks

SCREEN DATA

Diameter - Inches	Length - Feet	Slot Size - Inches
4"	10'	10 thds
Screen Type		**Depth to Bottom - Feet**
PVC		100'

Top of Lap Pipe or Reduction in Casing FEET

IF TELESCOPED OR MORE THAN ONE SCREEN: USE BACK PAGE

DESCRIPTION OF FORMATIONS ENCOUNTERED	FROM	TO	FORMATIONS (Continued)	FROM	TO
Clay	0	20			
Sand & gravel	20	100			
			IF MORE SPACE IS NEEDED, USE BACK		

06 23 98A09:40 RCVD

If well telescopes please
sketch and show depths.

GROUND LEVEL

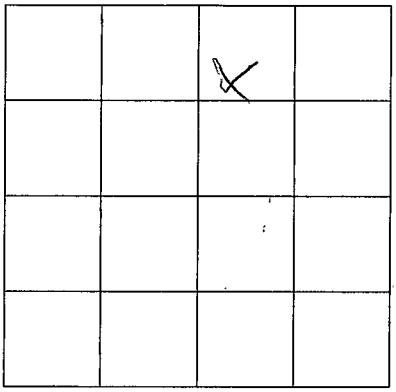

SECTION 9

Please indicate well location X.

ADDITIONAL INFORMATION

If more than one screen,
show location of each on sketch.