MISSISSIPPI DEPARTMENT OF ENVIRONMENTAL QUALITY
Office of Land and Water Resources

P. O. Box 10631
Jackson, MS 39289-0631
WATER WELL DRILLERS LOG

COUNTY WELL LOCATED: WaitHall	
WELL NUMBER: B-2067	CODED:
DATE WELL COMPLETED: 7/6/00	
PERMIT NUMBER: 0-508	
NAME OF DRILLING FIRM: Jordan Well Ser.	

NAME & MAILING ADDRESS OF LANDOWNER
Jimmy Crawford
185 Enon-Sartinville Rd
Jayess, Ms.

WELL LOCATION: SEC	TOWNSHIP	RANGE
4	4 (N) S	11 (E) W

DISTANCE	DIRECTION	NEAREST TOWN
2 Miles	N of	Sartinville

OTHER LANDMARK

WELL PURPOSE: Home, Irrigation, Municipal, Industrial, Fish Pond, etc.

PUMP DATA

PUMP TYPE (Circle One): Submersible, Turbine, Jet, Flowing Well, Other (Describe) ____

POWER TYPE (Circle One): Electric, Tractor, Diesel, Gasoline, Butane, Other (Describe) ____ H/P 1/2

Pump Capacity (GPM)	No. of Stages	Setting Depth
10	8	100 FT.

PUMP TEST

Well yielded ____ GPM with a drawdown of ____ ft. after ____ hours of pumping

WELL DATA

Well Depth	Casing Diameter (In.)	Casing Length (Ft.)
107	4	97

Type of Casing	Hole Depth	Depth to Static Water Level
PVC	107	80

TYPE OF COMPLETION: (Circle One or More): Gravel Packed, Underreamed, Telescoped, Natural Development, Open Hole, Other (Describe) ____

WELL GROUTED TO A DEPTH OF 10 FEET
Type Grout (circle one): Cement, Bentonite, or Mix

LOG DATA

TYPE OF LOG RUN (Circle One): No Log Run, Electric, Gamma Ray, Density, Sonic, Neutron, Other (Describe) ____

Name of Organization Running Log

GEOLOGIC DATA (Office Use Only)

Surface Elev.	Geologic Unit	Unit Thickness	Depth to Top
Subs. SWL	Date	Analysis	Aquifer Test

Driller's Remarks

SCREEN DATA

Diameter - Inches	Length - Feet	Slot Size - Inches
4	10	.010

Screen Type	Depth to Bottom - Feet
PVC	97

Top of Lap Pipe or Reduction in Casing
FEET — IF TELESCOPED OR MORE THAN ONE SCREEN: USE BACK PAGE

DESCRIPTION OF FORMATIONS ENCOUNTERED	FROM	TO
Top Soil	0	1
Sandy Clay	1	75
Sand	75	107

FORMATIONS (Continued) | FROM | TO

RECEIVED
JUL 19 2000
Dept. of Environmental Quality
Office of Land & Water Resources

IF MORE SPACE IS NEEDED, USE BACK

If well telescopes please
sketch and show depths.

GROUND LEVEL

 

If more than one screen,
show location of each on sketch.

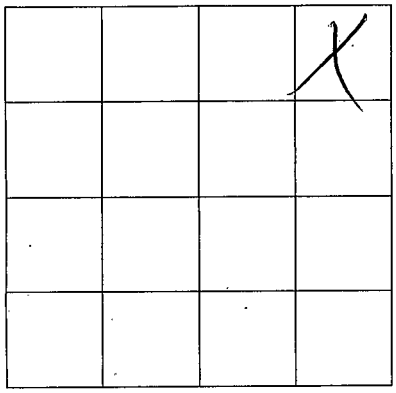

SECTION 4

Please indicate well location X.

ADDITIONAL INFORMATION