WALTHALL
C 70
8-24-73

MISSISSIPPI
BOARD OF WATER COMMISSIONERS
416 North State Street
Jackson, Mississippi 39201

CODED

WATER WELL DRILLERS LOG

8-24 1973 Fitzgerald well [illegible] Walthall
date well completed — firm name — county well located

LANDOWNER: Vera Tate

R.R. Tylertown
(mailing address)

WELL LOCATION:
sec. 13 T 3 (N/S) R 9 (E/W)

9 (distance) miles W (direction) of Tylertown (nearest town)

WELL PURPOSE: Home
(home, irrigation, municipal, industrial)

WELL COMPLETION DATA:

(1) diameter (inches) 4

(2) total depth (feet) 144

(3) static water level (feet) 100 below ~~above~~ top of ground.

(4) casing plastic (material), 136 (depth),
4 (size) if telescope see back.

(5) screen 8 (length), 136 (depth to top)
4 (size), plastic (material)

(6) pump 1/2 (HP) 10 (yield gpm)
ele (type power)

(7) electric log N (yes or no)
(organization running log)

(8) how well bottom plugged sand shale

DRILLERS REMARKS:

description of formations encountered	from	to
Red Clay	0	20
Red Sand	20	80
Red gravel	80	130
Coarse Sand gravel	130	144

CODED

OCT 9 1973

If well telescopes please sketch and show depths.

GROUND LEVEL

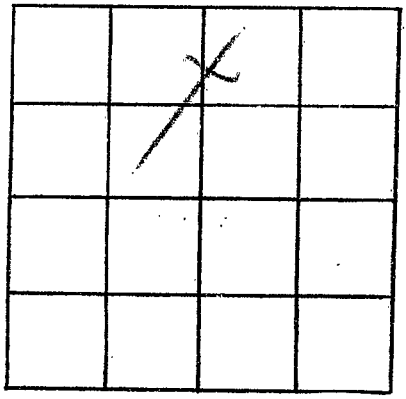

SECTION 13

Please indicate well location X.

ADDITIONAL INFORMATION

If more than one screen, show locations of each on sketch.