WALTHALL
C-93

Coded

MISSISSIPPI DEPARTMENT OF NATURAL RESOURCES

Bureau of Land and Water Resources
Southport Mall
P.O. Box 10631
Jackson, Mississippi 39209

WATER WELL DRILLERS LOG

08/18 1987 Layne-Central Co. Walthall
date well completed — firm name — county well located

LANDOWNER: TRANSCONTINENTAL GAS PIPE LINE CORPORATION
Rt. 3, Box 211
Tylertown, Miss. 39667
(mailing address)

WELL LOCATION: NW 1/4 of NE 1/4
sec. 9 T 3 N ~~S~~ R 10 E ~~W~~

____ miles ____ of ____
(distance) (direction) (nearest town)

WELL PURPOSE: Industrial
(home, irrigation, municipal, industrial)

WELL COMPLETION DATA:

(1) diameter (inches) 10"

(2) total depth (feet) 388'

(3) static water level (feet) 64 below ~~above~~ top of ground.

(4) casing Steel (material), 337' (depth),
10" (size) + 60' of 8"
if telescope see back.

(5) screen 40' 6" (length), 337' (depth to top)
8" (size), Stainless Steel (material)

(6) pump 20 (HP) 300 (yield gpm)
Electrical (type power)

(7) electric log yes (yes or no)
Layne-Central Co. (organization running log)

(8) how well bottom plugged
Back Pressure Valve

DRILLERS REMARKS:
Permit No.: GW7747

description of formations encountered	from	to
Red Clay	0'	25'
Sand	25'	65'
Sand + Gravel	65'	120'
Clay	120'	175'
Sand + Pea Gravel	175'	230'
Sand + Clay	230'	250'
Sand	250'	275'
Clay	275'	312'
Sand	312'	386'
Clay	386'	414'

If well telescopes please sketch and show depths.

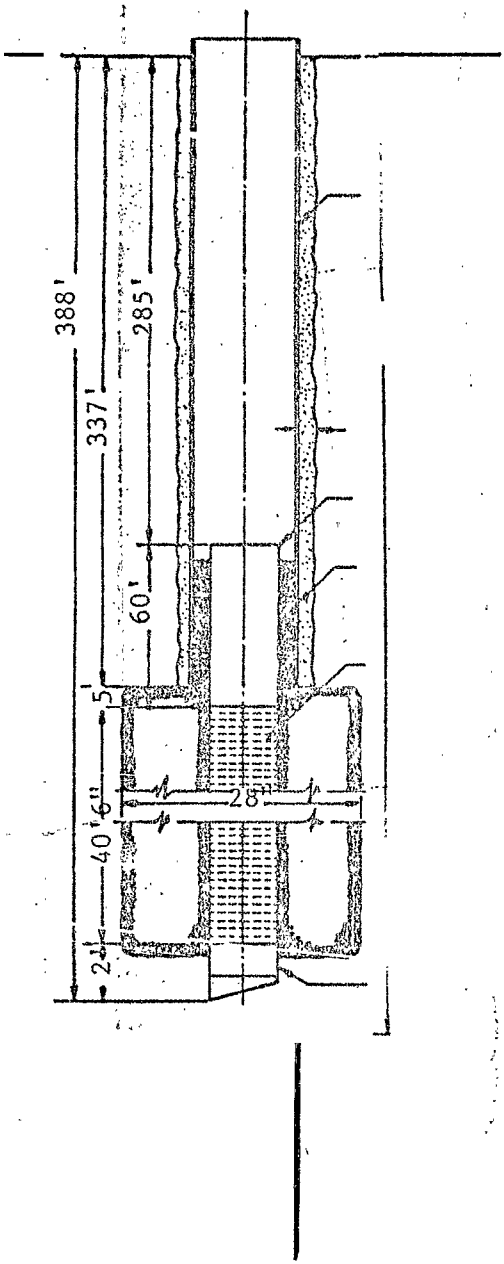

If more than one screen, show locations of each on sketch.

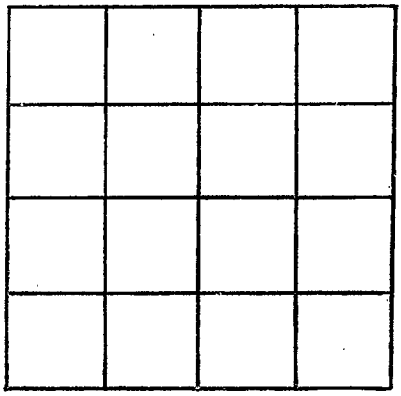

SECTION _____

Please indicate well location X.

ADDITIONAL INFORMATION