MISSISSIPPI DEPARTMENT OF NATURAL RESOURCES

Bureau of Land and Water Resources

P.O. Box 10631
Jackson, Mississippi 39209

WATER WELL DRILLERS LOG

COUNTY WELL LOCATED: Walthall	
WELL NUMBER: C	CODED:
DATE WELL COMPLETED: 3-29 88	
PERMIT NUMBER:	
NAME OF DRILLING FIRM: Fitzgerald Well Serv	

NAME & MAILING ADDRESS OF LANDOWNER
K. C. Barlow
R.R. 3, Tylertown Ms.

WELL LOCATION: SEC 36 TOWNSHIP 3 N/S RANGE 10 E/W

DISTANCE 8 Miles DIRECTION W of NEAREST TOWN Tylertown

OTHER LANDMARK

WELL PURPOSE: Home, Irrigation, Municipal, Industrial, Fish Pond, etc.
Home

PUMP DATA

PUMP TYPE (Circle One): Submersible, Turbine, Jet, Flowing Well, Other (Describe)

POWER TYPE (Circle One): Electric, Tractor, Diesel, Gasoline, Butane, Other (Describe)

Pump Capacity (GPM)	No. of Stages	Setting Depth
10	8	62 FT.

PUMP TEST

Well yielded 20 GPM with a drawdown of 2 ft. after 1 hours of pumping

WELL DATA

Well Depth	Casing Diameter (In.)	Casing Length (Ft.)
72	4	62

Type of Casing	Hole Depth	Depth to Static Water Level
PVC	72	40

TYPE OF COMPLETION: (Circle One or More): Gravel Packed, Underreamed, Telescoped, Natural Development, Open Hole, Other (Describe)

Top of Lap Pipe or Reduction in Casing FEET

IF TELESCOPED OR MORE THAN ONE SCREEN: USE BACK PAGE

LOG DATA

TYPE OF LOG RUN (Circle One): No Log Run, Electric, Gamma Ray, Density, Sonic, Neutron, Other (Describe)

Name of Organization Running Log

GEOLOGIC DATA (Office Use Only)

Surface Elev.	Geologic Unit	Unit Thickness	Depth to Top
Subs. SWL	Date	Analysis	Aquifer Test

Driller's Remarks

RECEIVED
MAY 05 1988
Mississippi Department of Natural Resources
Bureau of Land and Water Resources

SCREEN DATA

Diameter - Inches	Length - Feet	Slot Size - Inches
4	10	.014

Screen Type	Depth to Bottom - Feet
PVC	72

DESCRIPTION OF FORMATIONS ENCOUNTERED	FROM	TO
Red Clay	0	20
Red Sand	20	60
Course Sand & gravel	60	72

FORMATIONS (Continued)	FROM	TO

IF MORE SPACE IS NEEDED, USE BACK

If well telescopes please
sketch and show depths.

GROUND LEVEL

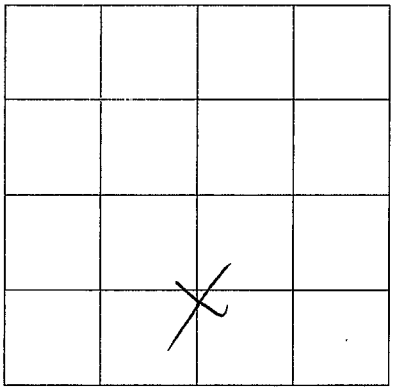

SECTION 36

Please indicate well location X.

ADDITIONAL INFORMATION

If more than one screen,
show location of each on sketch.