Walthall
D 2034
10-13-79

MISSISSIPPI DEPARTMENT OF NATURAL RESOURCES

Bureau of Land and Water Resources
Southport Mall
P.O. Box 10631
Jackson, Mississippi 39209

WATER WELL DRILLERS LOG

Oct 13 1979 Runwell Dr Walthall
date well completed — firm name — county well located

LANDOWNER: Greg Clegg
Rt 3 Tylertown
(mailing address)

WELL LOCATION:
sec. 17 T 3 N R 11 E

7 miles north of Tylertown
(distance) (direction) (nearest town)

WELL PURPOSE: home
(home, irrigation, municipal, industrial)

WELL COMPLETION DATA:

(1) diameter (inches) 4"
(2) total depth (feet) 122'
(3) static water level (feet) 76 below ~~above~~ top of ground.
(4) casing Plastic, bottom
(material), (depth)
— (size) if telescope see back.
(5) screen 5', 117'
(length), (depth to top)
4", Plastic
(size), (material)
(6) pump Sub 10
2 (HP) (yield gpm)
Elect
(type power)
(7) electric log no
(yes or no)
—
(organization running log)
(8) how well bottom plugged
Washing Stone

DRILLERS REMARKS:

description of formations encountered	from	to
Red Clay	0	17
Red Sand & Clay	17	105
Small Gravel & Sand	105	122

DEPT. OF NATURAL RESOURCES
BUREAU OF LAND & WATER RESOURCES
OCT 3 1980
RECEIVED

If well telescopes please sketch and show depths.

GROUND LEVEL

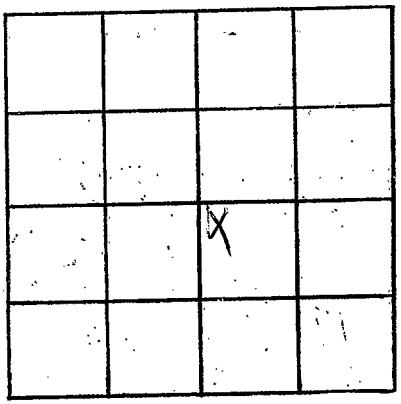

SECTION 17

Please indicate well location X.

ADDITIONAL INFORMATION

If more than one screen, show locations of each on sketch.