Walthall
E
3-67

MISSISSIPPI
BOARD OF WATER COMMISSIONERS
416 North State Street
Jackson, Mississippi 39201

WATER WELL DRILLERS LOG

3/16 1967 Andy's Drilling Co. Walthall
date well completed | firm name | county well located

LANDOWNER: Vernon Craft
Rt. 4
Tylertown Miss.
(mailing address)

WELL LOCATION:
sec. 13 T 2 N R 10 E
3½ miles NW of Tylertown
(distance) (direction) (nearest town)

WELL PURPOSE: Home
(home, irrigation, municipal, industrial)

WELL COMPLETION DATA:

(1) diameter (inches) 4"
(2) total depth (feet) 90'
(3) static water level (feet) 40' below ~~above~~ top of ground.
(4) casing P.V.C (material), 84' (depth),
4" (size) if telescope see back.
(5) screen 6' (length), ~~80~~ 84' (depth to top)
4" (size), P.V.C (material)
(6) pump did not install (HP) (yield gpm)
(type power)
(7) electric log No (yes or no)
(organization running log)
(8) how well bottom plugged Rock
Wash Valve

DRILLERS REMARKS:

description of formations encountered	from	to
Red Clay	0'	20'
Grey Clay	20'	40'
Sand / gravel	40'	45'
Chalk	45'	55'
Sand	55'	80'
Coarse sand / pea gravel	80'	90'

RECEIVED APR 7 10 07 AM '67 MISS. BOARD OF WATER COMM.

If well telescopes please sketch and show depths.

GROUND LEVEL

If more than one screen, show locations of each on sketch.

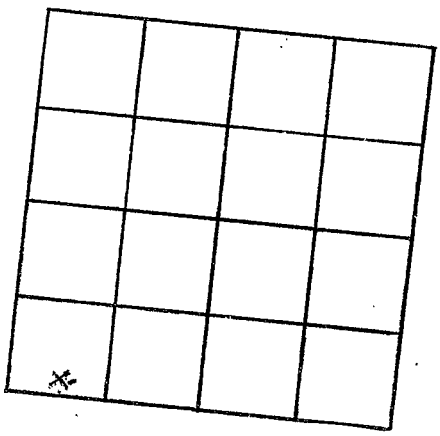

SECTION 13

Please indicate well location X.

ADDITIONAL INFORMATION