WALTHALL
E 2014
12/21/76

1321

MISSISSIPPI
BOARD OF WATER COMMISSIONERS
416 North State Street
Jackson, Mississippi 39201

WATER WELL DRILLERS LOG

12-21 1976 Tatum Well Drl Walthall
date well completed firm name county well located

LANDOWNER: Jerry Rushing
R.R. Tylertown
(mailing address)

WELL LOCATION:
sec. 14 T 2 N/S R 10 E/W
2 miles W of Tylertown
(distance) (direction) (nearest town)

WELL PURPOSE: Home
(home, irrigation, municipal, industrial)

WELL COMPLETION DATA:

(1) diameter (inches) 4
(2) total depth (feet) 148
(3) static water level (feet) 85 below/above top of ground.
(4) casing PVC (material), 140 (depth),
4 (size) If telescope see back.
(5) screen 8 (length), 140 (depth to top)
4 (size), PVC (material)
(6) pump 1/2 (HP) 10 (yield gpm)
Elec (type power)
(7) electric log No (yes or no)
(organization running log)
(8) how well bottom plugged Sand Shk

DRILLERS REMARKS:

description of formations encountered	from	to
Red Clay	0	20
Red Sand & rock	20	135
Coarse Sand & gravel	135	148

RECEIVED
DEC 23 1976
BOARD OF WATER COMM

If well telescopes please sketch and show depths.

GROUND LEVEL

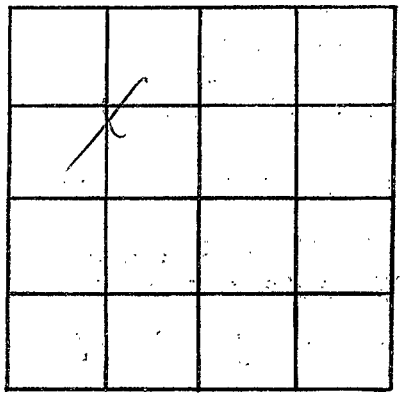

SECTION 14

Please indicate well location X.

ADDITIONAL INFORMATION

If more than one screen, show locations of each on sketch.