Wetthall
E
2063

MISSISSIPPI
BOARD OF WATER COMMISSIONERS
416 North State Street
Jackson, Mississippi 39201

WATER WELL DRILLERS LOG

9-1 1982 [illegible] Well Co. Wetthall
date well completed firm name county well located

LANDOWNER: E.J. Dorsey
R.R. Tylertown
(mailing address)

WELL LOCATION:
sec. 28 T 2 N/S R 10 E/W
4 miles SW of Tylertown
(distance) (direction) (nearest town)

WELL PURPOSE: Home
(home, irrigation, municipal, industrial)

WELL COMPLETION DATA:

(1) diameter (inches) 4
(2) total depth (feet) 120
(3) static water level (feet) 100 below/above top of ground.
(4) casing PVC (material), 112 (depth),
4 (size) if telescope see back.
(5) screen 8 (length), 112 (depth to top)
4 (size), PVC (material)
(6) pump 1/2 (HP) 10 (yield gpm)
Elec (type power)
(7) electric log no (yes or no)
(organization running log)
(8) how well bottom plugged Sand

DRILLERS REMARKS:

description of formations encountered	from	to
Red Clay	0	20
Red Sand	20	90
Coarse Sand & gravel	90	120

DEPT. OF NATURAL RESOURCES
BUREAU OF LAND & WATER RESOURCES
OCT 18 1982
RECEIVED

If well telescopes please sketch and show depths.

GROUND LEVEL

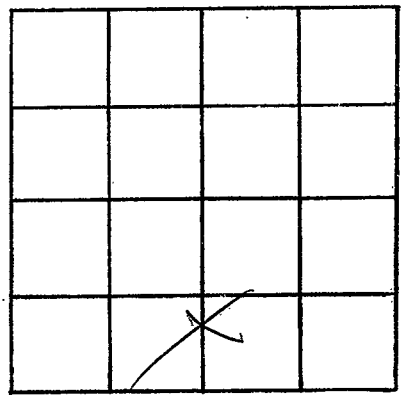

SECTION 28

Please indicate well location X.

ADDITIONAL INFORMATION

If more than one screen, show locations of each on sketch.