MISSISSIPPI DEPARTMENT OF NATURAL RESOURCES

Bureau of Land and Water Resources

P.O. Box 10631
Jackson, Mississippi 39209

WATER WELL DRILLERS LOG

COUNTY WELL LOCATED: Walthall	
WELL NUMBER: E	CODED:
2077	
DATE WELL COMPLETED: 7-8-88	

PERMIT NUMBER	
NAME OF DRILLING FIRM: FITZGERALD WELL SERV	

NAME & MAILING ADDRESS OF LANDOWNER
Kirby Veals
R.R. Tylertown Ms.

WELL LOCATION: SEC 1 TOWNSHIP 2 N/S RANGE 10 E/W

DISTANCE 3 Miles DIRECTION W of NEAREST TOWN Mesa

OTHER LANDMARK

WELL PURPOSE: Home, Irrigation, Municipal, Industrial, Fish Pond, etc.
Home

PUMP DATA

PUMP TYPE (Circle One): Submersible, Turbine, Jet, Flowing Well, Other (Describe)

POWER TYPE (Circle One): Electric, Tractor, Diesel, Gasoline, Butane, Other (Describe)

Pump Capacity (GPM)	No. of Stages	Setting Depth
10	10	90 FT.

PUMP TEST

Well yielded 10 GPM with a drawdown of 2 ft. after 2 hours of pumping

WELL DATA

Well Depth	Casing Diameter (In.)	Casing Length (Ft.)
95	4	85
Type of Casing	**Hole Depth**	**Depth to Static Water Level**
PVC	95	75

TYPE OF COMPLETION: (Circle One or More): Gravel Packed, Underreamed, Telescoped, Natural Development, Open Hole, Other (Describe)

Top of Lap Pipe or Reduction in Casing FEET

IF TELESCOPED OR MORE THAN ONE SCREEN: USE BACK PAGE

SCREEN DATA

Diameter - Inches	Length - Feet	Slot Size - Inches
4	10	.014
Screen Type	**Depth to Bottom - Feet**	
PVC	95	

LOG DATA

TYPE OF LOG RUN (Circle One): No Log Run, Electric, Gamma Ray, Density, Sonic, Neutron, Other (Describe)

Name of Organization Running Log

GEOLOGIC DATA (Office Use Only)

Surface Elev.	Geologic Unit	Unit Thickness	Depth to Top
Subs. SWL	Date	Analysis	Aquifer Test

Driller's Remarks

DESCRIPTION OF FORMATIONS ENCOUNTERED	FROM	TO
Red Clay	0	20
Red Sand	20	75
Coarse Red Sand	75	95

FORMATIONS (continued)	FROM	TO

IF MORE SPACE IS NEEDED, USE BACK

RECEIVED
SEP 13 1988
Department of Natural Resources
Bureau of Land & Water Resources

If well telescopes please
sketch and show depths.

GROUND LEVEL

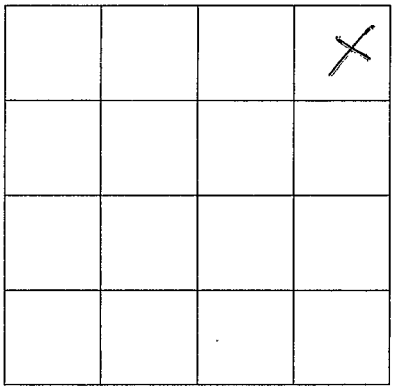

SECTION 1

Please indicate well location X.

ADDITIONAL INFORMATION

If more than one screen,
show location of each on sketch.