MISSISSIPPI DEPARTMENT OF ENVIRONMENTAL QUALITY
Office of Land and Water Resources

P. O. Box 10631
Jackson, MS 39289-0631
WATER WELL DRILLERS LOG

COUNTY WELL LOCATED: Oval-Thau	
WELL NUMBER: E	CODED: 2149
PERMIT NUMBER	
NAME OF DRILLING FIRM: Filgerald Well Service	
DATE WELL COMPLETED: 9-18-96	

NAME & MAILING ADDRESS OF LANDOWNER
Lonnie Duncan
RR Tylertown

WELL LOCATION: SEC 34 TOWNSHIP 2 N S RANGE 10 E W

DISTANCE 6 Miles DIRECTION NE of NEAREST TOWN Tylertown

OTHER LANDMARK

WELL PURPOSE: Home, Irrigation, Municipal, Industrial, Fish Pond, etc.
Chicken House

PUMP DATA

PUMP TYPE (Circle One): Submersible, Turbine, Jet, Flowing Well, Other (Describe)

POWER TYPE (Circle One): Electric, Tractor, Diesel, Gasoline, Butane, Other (Describe) H/P 1

Pump Capacity (GPM)	No. of Stages	Setting Depth
20	12	150' FT.

PUMP TEST
Well yielded 50' GPM with a drawdown of 1 ft. after 1 hours of pumping

WELL DATA

Well Depth	Casing Diameter (In.)	Casing Length (Ft.)
190'	4"	170'
Type of Casing	**Hole Depth**	**Depth to Static Water Level**
PVC	190'	96'

TYPE OF COMPLETION: (Circle One or More): Gravel Packed, Underreamed, Telescoped, Natural Development, Open Hole, Other (Describe)

WELL GROUTED TO A DEPTH OF 10 FEET
Type Grout (circle one): Cement, Bentonite, or Mix

LOG DATA

TYPE OF LOG RUN (Circle One): No Log Run, Electric, Gamma Ray, Density, Sonic, Neutron, Other (Describe)

Name of Organization Running Log

GEOLOGIC DATA (Office Use Only)

Surface Elev.	Geologic Unit	Unit Thickness	Depth to Top
Subs. SWL	Date	Analysis	Aquifer Test

Driller's Remarks

SCREEN DATA

Diameter - Inches	Length - Feet	Slot Size - Inches
4"	20	010/012
Screen Type		**Depth to Bottom - Feet**
PVC		190'

Top of Lap Pipe or Reduction in Casing
FEET IF TELESCOPED OR MORE THAN ONE SCREEN, USE BACK PAGE

DESCRIPTION OF FORMATIONS ENCOUNTERED	FROM	TO
Topsoil	0	5
red clay	5	40
sand + gravel	40	100
red clay	100	120
Fine sand	120	170
Course sand	170	190

FORMATIONS (Continued)	FROM	TO
IF MORE SPACE IS NEEDED, USE BACK		

RECEIVED
JAN 08 1997
Dept. of Environmental Quality
Office of Land & Water Resources

If well telescopes please
sketch and show depths.

GROUND LEVEL

 

If more than one screen,
show location of each on sketch.

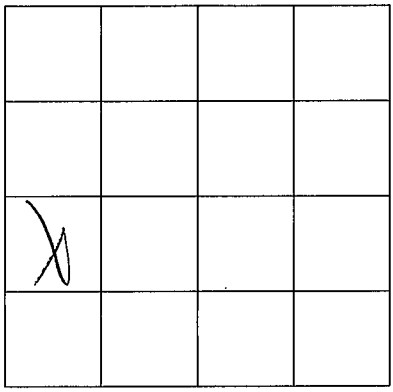

SECTION _____

Please indicate well location X.

ADDITIONAL INFORMATION