WALTHALL
F54
S-70

MISSISSIPPI
BOARD OF WATER COMMISSIONERS
416 North State Street
Jackson, Mississippi 39201

CODED

WATER WELL DRILLERS LOG

MAY 1970 E.B. SHERRARD WALTHALL
date well completed — firm name — county well located

LANDOWNER: BERTHA RATLIFF
TYLERTOWN, MISS.
(mailing address)

WELL LOCATION:
sec. 12 T 2 (N) S R 11 (E) W
6 1/2 miles ENE of TYLERTOWN
(distance) (direction) (nearest town)

WELL PURPOSE:
(home, irrigation, municipal, industrial)

WELL COMPLETION DATA:

(1) diameter (inches) 2"
(2) total depth (feet) 142
(3) static water level (feet) 55 below above top of ground.
(4) casing PLASTIC (material), 139 (depth),
2" (size) if telescope see back.
(5) screen 3' (length), (depth to top)
2" (size), S.S. (material)
(6) pump 3/4 (HP) 8 (yield gpm)
E (type power)
(7) electric log (yes or no)
(organization running log)
(8) how well bottom plugged BWV

DRILLERS REMARKS:

description of formations encountered	from	to
RED SANDY CLAY	0	60
BLUE CLAY	60	100
FINE SAND	100	120
LOOSE PEA GRAVEL		
MIXED COARSE SAND	120	142

CODED

AUG 13 1970
MISS. BD. OF WATER COMM.

If well telescopes please sketch and show depths.

GROUND LEVEL

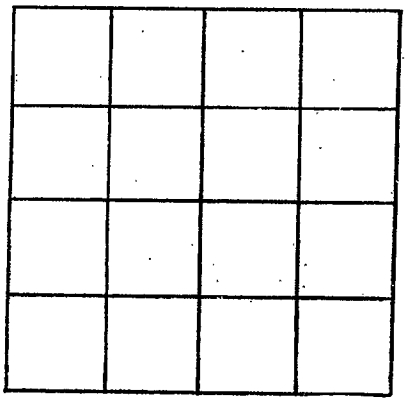

SECTION _____

Please indicate well location X.

ADDITIONAL INFORMATION

If more than one screen, show locations of each on sketch.