MISSISSIPPI DEPARTMENT OF ENVIRONMENTAL QUALITY
Office of Land and Water Resources

P. O. Box 10631
Jackson, MS 39289-0631
WATER WELL DRILLERS LOG

WELL NUMBER: F	CODED: 2061
DATE WELL COMPLETED: 10-14-96	
PERMIT NUMBER	
NAME OF DRILLING FIRM: Fitzgerald Well Service	

NAME & MAILING ADDRESS OF LANDOWNER: Yoder Joby, RR Tylertown

WELL LOCATION: SEC 14 TOWNSHIP 2 N/S RANGE 11 E/W

DISTANCE 4 Miles DIRECTION East of NEAREST TOWN Tylertown

OTHER LANDMARK

WELL PURPOSE: Home, Irrigation, Municipal, Industrial, Fish Pond, etc.

PUMP DATA

PUMP TYPE (Circle One): Submersible, Turbine, Jet, Flowing Well, Other (Describe)

POWER TYPE (Circle One): Electric, Tractor, Diesel, Gasoline, Butane, Other (Describe) H/P

Pump Capacity (GPM)	No. of Stages	Setting Depth
	1	FT.

PUMP TEST

Well yielded 50 GPM with a drawdown of 1 ft. after 1 hours of pumping

WELL DATA

Well Depth	Casing Diameter (in.)	Casing Length (Ft.)
100'	4"	90'

Type of Casing	Hole Depth	Depth to Static Water Level
PVC	100'	51'

TYPE OF COMPLETION: (Circle One or More): Gravel Packed, Underreamed, Telescoped, Natural Development, Open Hole, Other (Describe)

WELL GROUTED TO A DEPTH OF 16 FEET
Type Grout (circle one): Cement, Bentonite, or Mix

LOG DATA

TYPE OF LOG RUN (Circle One): No Log Run, Electric, Gamma Ray, Density, Sonic, Neutron, Other (Describe)

Name of Organization Running Log

GEOLOGIC DATA (Office Use Only)

Surface Elev.	Geologic Unit	Unit Thickness	Depth to Top
Subs. SWL	Date	Analysis	Aquifer Test

Driller's Remarks

SCREEN DATA

Diameter - Inches	Length - Feet	Slot Size - Inches
4"	10	.012

Screen Type	Depth to Bottom - Feet
PVC	100'

Top of Lap Pipe or Reduction in Casing FEET

IF TELESCOPED OR MORE THAN ONE SCREEN: USE BACK PAGE

DESCRIPTION OF FORMATIONS ENCOUNTERED	FROM	TO
Topsoil	0	5
red clay	5	20
Sand + gravel	20	90
course sand	90	100

FORMATIONS Continued | FROM | TO

IF MORE SPACE IS NEEDED, USE BACK

RECEIVED
JAN 09 1997
Dept. of Environmental Quality
Office of Land & Water Resources

If well telescopes please
sketch and show depths.

GROUND LEVEL

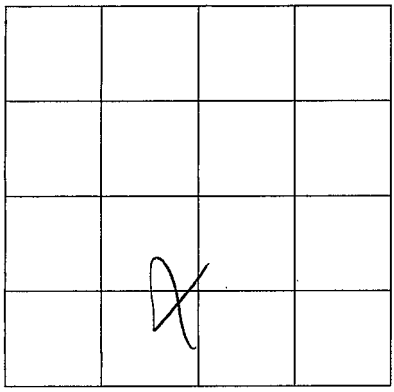

SECTION _____

Please indicate well location X.

ADDITIONAL INFORMATION

If more than one screen,
show location of each on sketch.