MISSISSIPPI DEPARTMENT OF ENVIRONMENTAL QUALITY
Office of Land and Water Resources

P. O. Box 10631
Jackson, MS 39289-0631
WATER WELL DRILLERS LOG

COUNTY WELL LOCATED: Walthall
WELL NUMBER: F-2066 CODED:
DATE WELL COMPLETED: 6-2-00

PERMIT NUMBER: 0-621
NAME OF DRILLING FIRM: Daniel Boone

NAME & MAILING ADDRESS OF LANDOWNER
Merlene Rayford
72 Magee Creek School Rd
Tylertown, MS

WELL LOCATION — SEC: 16 TOWNSHIP: 2 (N) (S) RANGE: 11 (E) (W)

DISTANCE: 2 Miles DIRECTION: NE of NEAREST TOWN: Tylertown

OTHER LANDMARK:

WELL PURPOSE: (Home) Irrigation, Municipal, Industrial, Fish Pond, etc.

PUMP DATA

PUMP TYPE (Circle One): (Submersible) Turbine, Jet, Flowing Well, Other (Describe)

POWER TYPE (Circle One): (Electric) Tractor, Diesel, Gasoline, Butane, Other (Describe) H/P 1

Pump Capacity (GPM)	No. of Stages	Setting Depth
12		95 FT.

PUMP TEST
Well yielded 18 GPM with a drawdown of 10 ft. after 8 hours of pumping

WELL DATA

Well Depth	Casing Diameter (In.)	Casing Length (Ft.)
100'	4"	80

Type of Casing	Hole Depth	Depth to Static Water Level
PVC	100'	78'

TYPE OF COMPLETION: (Circle One or More): (Gravel Packed), Underreamed, Telescoped, Natural Development, Open Hole, Other (Describe)

WELL GROUTED TO A DEPTH OF 10 FEET
Type Grout (circle one): (Cement), Bentonite, or Mix

LOG DATA

TYPE OF LOG RUN (Circle One): (No Log Run), Electric, Gamma Ray, Density, Sonic, Neutron, Other (Describe)

Name of Organization Running Log

GEOLOGIC DATA (Office Use Only)

Surface Elev:	Geologic Unit	Unit Thickness	Depth to Top
Subs. SWL	Date	Analysis	Aquifer Test

Driller's Remarks

SCREEN DATA

Diameter - Inches	Length - Feet	Slot Size - Inches
4"	20'	.008

Screen Type	Depth to Bottom - Feet
PVC Sch. 40	0

Top of Lap Pipe on Reduction in Casing FEET (IF TELESCOPED OR MORE THAN ONE SCREEN: USE BACK PAGE)

RECEIVED
AUG 07 2000
Dept. of Environmental Quality
Office of Land & Water Resources

DESCRIPTION OF FORMATIONS ENCOUNTERED	FROM	TO
Clay	0	18
Sand	18	60
Gravel	60	100

FORMATIONS (Continued)	FROM	TO

IF MORE SPACE IS NEEDED, USE BACK

If well telescopes please
sketch and show depths.

GROUND LEVEL

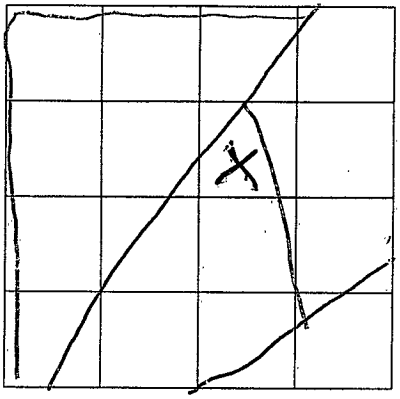

SECTION 16

Please indicate well location X.

ADDITIONAL INFORMATION

If more than one screen,
show location of each on sketch.