MISSISSIPPI DEPARTMENT OF NATURAL RESOURCES

Bureau of Land and Water Resources

CODED

P.O. Box 10631
Jackson, Mississippi 39209

WATER WELL DRILLERS LOG

WELL LOCATED	Calthall
WELL NUMBER	No. 1 G 52
CODED	
	morris 35-9
DATE WELL COMPLETED	6-6-89

PERMIT NUMBER	330C
NAME OF DRILLING FIRM	Griner Drilling Service, Inc.

NAME & MAILING ADDRESS OF LANDOWNER

Exeter Drilling Co.
P.O. Box 1478
Houston, Tx. 77001

WELL LOCATION: SEC 35 TOWNSHIP 2 (N) S RANGE 12 (E) W

DISTANCE 2630'N & 500'W Miles DIRECTION of NEAREST TOWN of

OTHER LANDMARK SE/cor

WELL PURPOSE: Home, Irrigation, Municipal, Industrial, Fish Pond, etc.
Oilfield Rig Supply

PUMP DATA

PUMP TYPE (Circle One): (Submersible), Turbine, Jet, Flowing Well, Other (Describe) 72 H.P.

POWER TYPE (Circle One): (Electric), Tractor, Diesel, Gasoline, Butane, Other (Describe) 230 volt 3 phase

Pump Capacity (GPM)	No. of Stages	Setting Depth
100	—	FT.

PUMP TEST

Well yielded 90-100 GPM with a drawdown of N/A ft. after — hours of pumping

WELL DATA

Well Depth	Casing Diameter (In.)	Casing Length (Ft.)
380'	4"	360'

Type of Casing	Hole Depth	Depth to Static Water Level
PVC	380'	85'

TYPE OF COMPLETION: (Circle One or More): (Gravel Packed), Underreamed, Telescoped, Natural Development, Open Hole, Other (Describe)

Top of Lap Pipe or Reduction in Casing FEET

IF TELESCOPED OR MORE THAN ONE SCREEN: USE BACK PAGE

SCREEN DATA

Diameter - Inches	Length - Feet	Slot Size - Inches
4"	20'	.010

Screen Type	Depth to Bottom - Feet
PVC	360' - 380'

LOG DATA

TYPE OF LOG RUN (Circle One): Electric, Gamma Ray, Density, Sonic, Neutron, Other (Describe) — No Log Run

Name of Organization Running Log

GEOLOGIC DATA (Office Use Only)

Surface Elev.	Geologic Unit	Unit Thickness	Depth to Top
Subs. SWL	Date	Analysis	Aquifer Test

Driller's Remarks

RECEIVED
JUL 06 1989
Department of Natural Resources
Bureau of Land & Water Resources

DESCRIPTION OF FORMATIONS ENCOUNTERED	FROM	TO
streaked	0	80
good sand	80	147
pea gravel	147	200
pea gravel	200	300
course sand	300	380

FORMATIONS (Continued)	FROM	TO

IF MORE SPACE IS NEEDED, USE BACK

If well telescopes please
sketch and show depths.

GROUND LEVEL

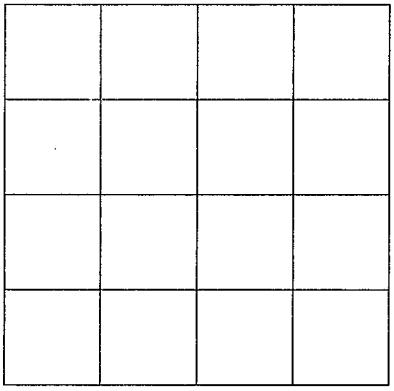

SECTION _____

Please indicate well location X.

ADDITIONAL INFORMATION

If more than one screen,
show location of each on sketch.