MISSISSIPPI DEPARTMENT OF ENVIRONMENTAL QUALITY
Office of Land and Water Resources

P. O. Box 10631
Jackson, MS 39289-0631
WATER WELL DRILLERS LOG

COUNTY WELL LOCATED: WALTHALL	
WELL NUMBER: G	CODED:
PERMIT NUMBER:	
NAME OF DRILLING FIRM: FITZGERALD Well SERV	
DATE WELL COMPLETED: NOV-19-93	

NAME & MAILING ADDRESS OF LANDOWNER
LARRY MARTIN
RR. Tylertown Ms.

WELL LOCATION: SEC 33 TOWNSHIP 2 N/S RANGE 12 E/W

DISTANCE 6 Miles DIRECTION E of NEAREST TOWN McComb

OTHER LANDMARK

WELL PURPOSE: Home, Irrigation, Municipal, Industrial, Fish Pond, etc.
Poultry House

PUMP DATA

PUMP TYPE (Circle One): Submersible, Turbine, Jet, Flowing Well, Other (Describe)

POWER TYPE (Circle One): Electric, Tractor, Diesel, Gasoline, Butane, Other (Describe) H/P 1 1/2

Pump Capacity (GPM)	No. of Stages	Setting Depth
20	14	105 FT.

PUMP TEST
Well yielded 50 GPM with a drawdown of 2 ft. after 2 hours of pumping

WELL DATA

Well Depth	Casing Diameter (In.)	Casing Length (Ft.)
135	4	125
Type of Casing	**Hole Depth**	**Depth to Static Water Level**
PVC	135	62

TYPE OF COMPLETION: (Circle One or More): Gravel Packed, Underreamed, Telescoped, Natural Development, Open Hole, Other (Describe)

WELL GROUTED TO A DEPTH OF 10 FEET
Type Grout (circle one): Cement, Bentonite, Or Mix

LOG DATA

TYPE OF LOG RUN (Circle One): No Log Run, Electric, Gamma Ray, Density, Sonic, Neutron, Other (Describe)

Name of Organization Running Log

GEOLOGIC DATA (Office Use Only)

Surface Elev.	Geologic Unit	Unit Thickness	Depth to Top
Subs. SWL	Date	Analysis	Aquifer Test

Driller's Remarks

SCREEN DATA

Diameter - Inches	Length - Feet	Slot Size - Inches
4	10	10/14
Screen Type	**Depth to Bottom - Feet**	
PVC	135	

DESCRIPTION OF FORMATIONS ENCOUNTERED	FROM	TO
Red Clay	0	15
Red Sand	15	120
Coarse Sand & gravel	120	135

FORMATIONS (Continued)	FROM	TO

RECEIVED
JAN 05 1994
Dept. of Environmental Quality
Office of Land & Water Resources

IF MORE SPACE IS NEEDED, USE BACK

If well telescopes please
sketch and show depths.

GROUND LEVEL

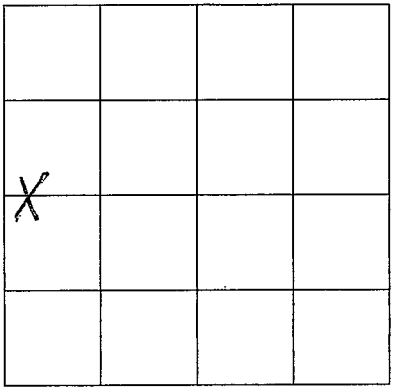

SECTION 33

Please indicate well location X.

ADDITIONAL INFORMATION

If more than one screen,
show location of each on sketch.