MISSISSIPPI DEPARTMENT OF ENVIRONMENTAL QUALITY
Office of Land and Water Resources

P. O. Box 10631
Jackson, MS 39289-0631
WATER WELL DRILLERS LOG

COUNTY WELL LOCATED: Walthall	
WELL NUMBER: G-2037	CODED:
DATE WELL COMPLETED: 6-13-00	
PERMIT NUMBER: 0-621	
NAME OF DRILLING FIRM: Daniel Boone	

NAME & MAILING ADDRESS OF LANDOWNER
Bill Pittman
185 Joe Pittman Rd.
Tylertown, MS

WELL LOCATION	SEC	TOWNSHIP	RANGE
	35	2 (N) S	12 (E) W

DISTANCE	DIRECTION	NEAREST TOWN
10 Miles	East	of Tylertown

OTHER LANDMARK

WELL PURPOSE: Home, Irrigation, Municipal, Industrial, Fish Pond, etc.

PUMP DATA

PUMP TYPE (Circle One): Submersible, Turbine, Jet, Flowing Well, Other (Describe)

POWER TYPE (Circle One): Electric, Tractor, Diesel, Gasoline, Butane, Other (Describe) H/P 1½

Pump Capacity (GPM)	No. of Stages	Setting Depth
25		160 FT.

PUMP TEST
Well yielded 35 GPM with a drawdown of 30 ft. after 30 hours of pumping

WELL DATA

Well Depth	Casing Diameter (In.)	Casing Length (Ft.)
190'	4"	160'
Type of Casing	**Hole Depth**	**Depth to Static Water Level**
PVC	190	118'

TYPE OF COMPLETION: (Circle One or More): Gravel Packed, Underreamed, Telescoped, Natural Development, Open Hole, Other (Describe)

WELL GROUTED TO A DEPTH OF 9 FEET
Type Grout (circle one): Cement, Bentonite, or Mix

LOG DATA

TYPE OF LOG RUN (Circle One): No Log Run, Electric, Gamma Ray, Density, Sonic, Neutron, Other (Describe)

Name of Organization Running Log

GEOLOGIC DATA (Office Use Only)

Surface Elev.	Geologic Unit	Unit Thickness	Depth to Top
Subs. SWL	Date	Analysis	Aquifer Test

Driller's Remarks

RECEIVED
AUG 2 1 2000

Top of Lap Pipe or Reduction in Casing
FEET

IF TELESCOPED OR MORE THAN ONE SCREEN, USE BACK PAGE.

SCREEN DATA

Diameter - Inches	Length - Feet	Slot Size - Inches
4"	30'	.008
Screen Type	**Depth to Bottom - Feet**	
PVC Sch. 40	0	

DESCRIPTION OF FORMATIONS ENCOUNTERED	FROM	TO
Clay	0	9
Sand	9	82
Clay	82	130
Sand	130	190

FORMATIONS (Continued)	FROM	TO

Dept. of Environmental Quality
Office of Land & Water Resources

IF MORE SPACE IS NEEDED, USE BACK

If well telescopes please
sketch and show depths.

GROUND LEVEL

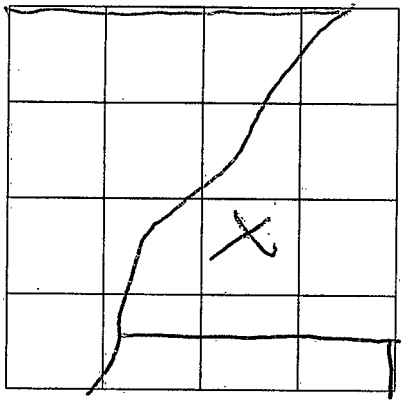

SECTION 35

Please indicate well location X.

ADDITIONAL INFORMATION

If more than one screen,
show location of each on sketch.