Walthall
H 49
2-12-70

MISSISSIPPI
BOARD OF WATER COMMISSIONERS
416 North State Street
Jackson, Mississippi 39201

CODED

Walthall

WATER WELL DRILLERS LOG

2-12 19 70 Filgueblwell Sv [illegible]
date well completed firm name county well located

LANDOWNER: Carrie R. Fortenberry
(mailing address)

WELL LOCATION:
sec. 26 T 1 (N) S R 9 (E) W
5 miles SE of Progress
(distance) (direction) (nearest town)

WELL PURPOSE: Home
(home, irrigation, municipal, industrial)

WELL COMPLETION DATA:

(1) diameter (inches) 4
(2) total depth (feet) 140
(3) static water level (feet) 75 below ~~above~~ top of ground.
(4) casing Plastic (material), 132 (depth), 4 (size) If telescope see back.
(5) screen 8 (length), 132 (depth to top), 4 (size), Plastic (material)
(6) pump 3/4 (HP) 4 (yield gpm) Elec (type power)
(7) electric log N (yes or no)
(organization running log)
(8) how well bottom plugged Wood plug

DRILLERS REMARKS:

description of formations encountered	from	to
Red Clay	0	20
Red Sand	20	70
Red gravel	70	90
Red Sand	90	130
Coarse Sand & gravel	130	140

RECD FEB 27 1970
MISS. BD. OF WATER COMM.

If well telescopes please sketch and show depths.

GROUND LEVEL

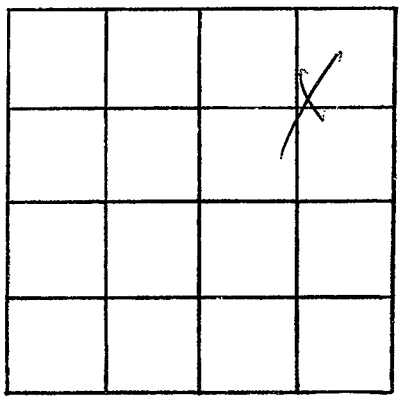

SECTION 26

Please indicate well location X.

ADDITIONAL INFORMATION

If more than one screen, show locations of each on sketch.