WALTHALL
H 80

CODED

MISSISSIPPI DEPARTMENT OF NATURAL RESOURCES

Bureau of Land and Water Resources
Southport Mall
P.O. Box 10631
Jackson, Mississippi 39209

WATER WELL DRILLERS LOG

1-27-94 19, Amite Pump & well — WALTHALL
date well completed License #0-235 firm name county well located

LANDOWNER: Jerry Rayborn
30481 Hwy 25
Franklinton, LA
(mailing address) 70438

WELL LOCATION:
sec. 34 T 1 (N/S) R 10 (E/W)
1/4 miles State Line
(distance) (direction) (nearest town)

WELL PURPOSE: irrigation
(home, irrigation, municipal, industrial)

WELL COMPLETION DATA:

(1) diameter (inches) 7 1/2, 4"
(2) total depth (feet) 460'
(3) static water level (feet) Flow below above top of ground.
(4) casing Sch 40 Pvc (material), 440 (depth),
4" (size) if telescope see back.
(5) screen 20' #8 (length), 460' - 440' (depth to top)
4" (size), Sch 40 Pvc (material)
(6) pump Flow (HP) 25 (yield gpm)
None (type power)
(7) electric log NO (yes or no)
(organization running log)
(8) how well bottom plugged N/A

DRILLERS REMARKS:

description of formations encountered	from	to
Clay	0	5
gravel	5	42
Clay	42	60
Clay & Sand	60	80
Sand & pea gravel	80	200
Clay & Sand	200	260
Sand	260	270
Clay & Sand	270	320
Sand & pea gravel	320	370
Clay & Sand	370	415
Sand	415	460

RECEIVED
FEB 25 1994
Dept. of Environmental Quality
Office of Land & Water Resources

If well telescopes please sketch and show depths.

GROUND LEVEL

If more than one screen, show locations of each on sketch.

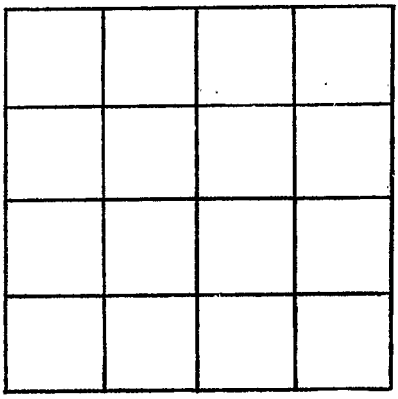

SECTION _____

Please indicate well location X.

ADDITIONAL INFORMATION