CODED

Walthall
J5
9-26-68

MISSISSIPPI
BOARD OF WATER COMMISSIONERS
416 North State Street
Jackson, Mississippi 39201

WATER WELL DRILLERS LOG

9-26 1968 Fitzgerald well firm Walthall
date well completed firm name county well located

LANDOWNER: Ezzeroid Andrews
RR. Tylertown Miss.
(mailing address)

WELL LOCATION:
sec. 8 T 1 N/S R 11 E/W
4 miles SE of Tylertown
(distance) (direction) (nearest town)

WELL PURPOSE: home
(home, irrigation, municipal, industrial)

WELL COMPLETION DATA:
(1) diameter (inches) 4
(2) total depth (feet) 208
(3) static water level (feet) 75 below ~~above~~ top of ground.
(4) casing Plastic (material), 202 (depth),
4 (size) if telescope see back.
(5) screen 6' (length), 202 (depth to top)
4 (size), Plastic (material)
(6) pump ? (HP) ? (yield gpm)
Elec (type power)
(7) electric log no (yes or no)
(organization running log)
(8) how well bottom plugged Wooden plug

DRILLERS REMARKS:

description of formations encountered	from	to
Red clay	0	20
Red Sand	20	160
Red Clay	160	200
Coarse Sand & gravel	200	208

NOV 20 1968
MISS. BOARD OF WATER COMM.

If well telescopes please sketch and show depths.

GROUND LEVEL

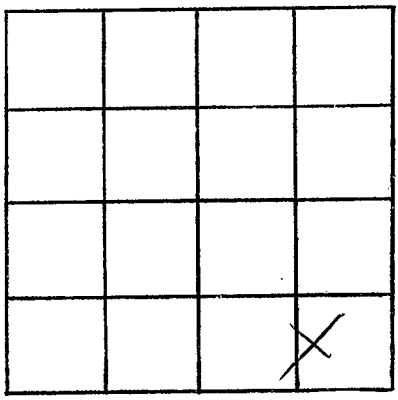

SECTION 8

Please indicate well location X.

ADDITIONAL INFORMATION

If more than one screen, show locations of each on sketch.