MISSISSIPPI DEPARTMENT OF NATURAL RESOURCES

Bureau of Land and Water Resources

P.O. Box 10631
Jackson, Mississippi 39209

WATER WELL DRILLERS LOG

COUNTY WELL LOCATED: Walthall	
WELL NUMBER: J	CODED:
DATE WELL COMPLETED: OCT 1-89	
PERMIT NUMBER:	
NAME OF DRILLING FIRM: FITZGERALD Well Serv.	

NAME & MAILING ADDRESS OF LANDOWNER: Richard Felo, R.R. Tylertown, Ms.

WELL LOCATION: SEC 11 TOWNSHIP 1 N/S RANGE 11 E/W

DISTANCE 8 Miles DIRECTION SE of NEAREST TOWN Tylertown

OTHER LANDMARK:

WELL PURPOSE: Home, Irrigation, Municipal, Industrial, Fish Pond, etc.: Home

PUMP DATA

PUMP TYPE (Circle One): Submersible, Turbine, Jet, Flowing Well, Other (Describe) _____

POWER TYPE (Circle One): Electric, Tractor, Diesel, Gasoline, Butane, Other (Describe) _____ H/P _____

Pump Capacity (GPM)	No. of Stages	Setting Depth
10	9	95 FT.

PUMP TEST

Well yielded 20 GPM with a drawdown of 2 ft. after 2 hours of pumping

WELL DATA

Well Depth	Casing Diameter (In.)	Casing Length (Ft.)
175	4	165

Type of Casing	Hole Depth	Depth to Static Water Level
PVC	175	61

TYPE OF COMPLETION: (Circle One or More): Gravel Packed, Underreamed, Telescoped, Natural Development, Open Hole, Other (Describe) _____

Top of Lap Pipe or Reduction in Casing: FEET

IF TELESCOPED OR MORE THAN ONE SCREEN: USE BACK PAGE

LOG DATA

TYPE OF LOG RUN (Circle One): No Log Run, Electric, Gamma Ray, Density, Sonic, Neutron, Other (Describe) _____

Name of Organization Running Log:

GEOLOGIC DATA (Office Use Only)

Surface Elev.	Geologic Unit	Unit Thickness	Depth to Top
Subs. SWL	Date	Analysis	Aquifer Test

Driller's Remarks:

SCREEN DATA

Diameter - Inches	Length - Feet	Slot Size - Inches
4	10	10/14

Screen Type	Depth to Bottom - Feet
PVC	175

DESCRIPTION OF FORMATIONS ENCOUNTERED	FROM	TO
Red Clay	0	20
Red Sand	20	166
Coarse Sand & gravel	166	175

FORMATIONS (Continued)	FROM	TO

RECEIVED
NOV 07 1989
Department of Natural Resources
Bureau of Land & Water Resources

IF MORE SPACE IS NEEDED, USE BACK

If well telescopes please
sketch and show depths.

GROUND LEVEL

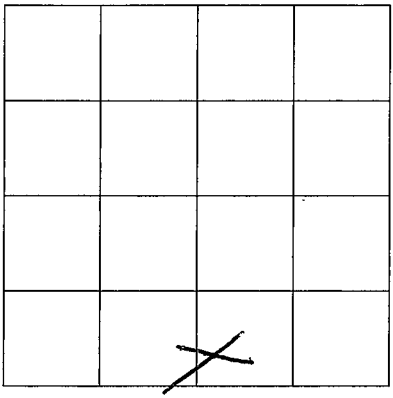

SECTION 11

Please indicate well location X.

ADDITIONAL INFORMATION

If more than one screen,
show location of each on sketch.