MISSISSIPPI DEPARTMENT OF ENVIRONMENTAL QUALITY
Office of Land and Water Resources

P. O. Box 10631
Jackson, MS 39289-0631

WATER WELL DRILLERS LOG

COUNTY WELL LOCATED	Walthall
WELL NUMBER	1
CODED	
	2047
DATE WELL COMPLETED	MAY 21, 94
PERMIT NUMBER	
NAME OF DRILLING FIRM	FITZGERALD WELL SERV

NAME & MAILING ADDRESS OF LANDOWNER: Lionel Favrier
RR. Tylertown MS

WELL LOCATION: SEC 14 TOWNSHIP 1 N/S RANGE 11 E/W

DISTANCE 5 Miles DIRECTION SE of NEAREST TOWN Tylertown

OTHER LANDMARK:

WELL PURPOSE: Home, Irrigation, Municipal, Industrial, Fish Pond, etc.: Home

PUMP DATA

PUMP TYPE (Circle One): Submersible, Turbine, Jet, Flowing Well, Other (Describe)

POWER TYPE (Circle One): Electric, Tractor, Diesel, Gasoline, Butane, Other (Describe) H/P 3/4

Pump Capacity (GPM)	No. of Stages	Setting Depth
10	12	100 FT.

PUMP TEST

Well yielded 20 GPM with a drawdown of 2 ft. after 2 hours of pumping

WELL DATA

Well Depth	Casing Diameter (In.)	Casing Length (Ft.)
165	4	155

Type of Casing	Hole Depth	Depth to Static Water Level
PVC	165	65

TYPE OF COMPLETION: (Circle One or More): Gravel Packed, Underreamed, Telescoped, Natural Development, Open Hole, Other (Describe)

WELL GROUTED TO A DEPTH OF 10 FEET
Type Grout (circle one): Cement, Bentonite, or Mix

LOG DATA

TYPE OF LOG RUN (Circle One): No Log Run, Electric, Gamma Ray, Density, Sonic, Neutron, Other (Describe)

Name of Organization Running Log

GEOLOGIC DATA (Office Use Only)

Surface Elev.	Geologic Unit	Unit Thickness	Depth to Top
Subs. SWL	Date	Analysis	Aquifer Test

Driller's Remarks

Top of Lap Pipe or Reduction in Casing FEET

IF TELESCOPED OR MORE THAN ONE SCREEN: USE BACK PAGE

SCREEN DATA

Diameter - Inches	Length - Feet	Slot Size - Inches
4	10	.012

Screen Type	Depth to Bottom - Feet
PVC	165

RECEIVED
JUL 2 1994
Dept. of Environmental Quality
Office of Land & Water Resources

DESCRIPTION OF FORMATIONS ENCOUNTERED	FROM	TO
Red Clay	0	20
Red Sand	20	145
Course Sand & Gravel	145	165

FORMATIONS (Continued)	FROM	TO

IF MORE SPACE IS NEEDED, USE BACK

If well telescopes please
sketch and show depths.

GROUND LEVEL

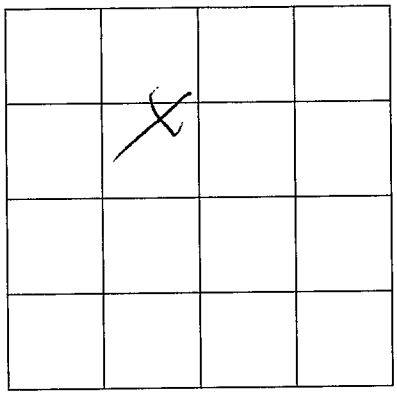

SECTION 14

Please indicate well location X.

ADDITIONAL INFORMATION

If more than one screen,
show location of each on sketch.