MISSISSIPPI DEPARTMENT OF ENVIRONMENTAL QUALITY
Office of Land and Water Resources

P. O. Box 10631
Jackson, MS 39289-0631

WATER WELL DRILLERS LOG

COUNTY WELL LOCATED: Walthall	
WELL NUMBER: J-2061	CODED:
PERMIT NUMBER: 0621	
NAME OF DRILLING FIRM: Daniel Boone	
DATE WELL COMPLETED: 7-21-01	

NAME & MAILING ADDRESS OF LANDOWNER
Mike Fortenberry
385 Mt. Moriah Rd.
Tylertown, MS

WELL LOCATION: SEC 11 TOWNSHIP 1 (N) S RANGE 11 (E) W

DISTANCE 6 Miles DIRECTION SE of NEAREST TOWN Tylertown

OTHER LANDMARK

WELL PURPOSE: Home, Irrigation, Municipal, (Industrial), Fish Pond, etc.

PUMP DATA

PUMP TYPE (Circle One): (Submersible), Turbine, Jet, Flowing Well, Other (Describe)

POWER TYPE (Circle One): (Electric), Tractor, Diesel, Gasoline, Butane, Other (Describe) H/P 2

Pump Capacity (GPM)	No. of Stages	Setting Depth
28		135 FT.

PUMP TEST
Well yielded 40 GPM with a drawdown of 25 ft. after 40 hours of pumping

WELL DATA

Well Depth	Casing Diameter (In.)	Casing Length (Ft.)
180	4"	140'
Type of Casing	**Hole Depth**	**Depth to Static Water Level**
PVC	180	87'

TYPE OF COMPLETION: (Circle One or More): (Gravel Packed), Underreamed, Telescoped, Natural Development, Open Hole, Other (Describe)

WELL GROUTED TO A DEPTH OF 8 FEET
Type Grout (circle one): (Cement), Bentonite, or Mix

LOG DATA

TYPE OF LOG RUN (Circle One): (No Log Run), Electric, Gamma Ray, Density, Sonic, Neutron, Other (Describe)

Name of Organization Running Log

GEOLOGIC DATA (Office Use Only)

Surface Elev.	Geologic Unit	Unit Thickness	Depth to Top
Subs. SWL	Date	Analysis	Aquifer Test

Driller's Remarks

Top of Lap Pipe or Reduction in Casing
FEET — IF TELESCOPED OR MORE THAN ONE SCREEN: USE BACK PAGE

SCREEN DATA

Diameter - Inches	Length - Feet	Slot Size - Inches
4"	40'	.008
Screen Type	**Depth to Bottom - Feet**	
PVC Sch. 40	0	

DESCRIPTION OF FORMATIONS ENCOUNTERED	FROM	TO	FORMATIONS (Continued)	FROM	TO
Clay	0	8			
Sand	8	65			
Clay	65	105			
Sand + Pea Gravel Mix	105	180			
			IF MORE SPACE IS NEEDED, USE BACK		

REC'D AUG 31 2001

If well telescopes please
sketch and show depths.

GROUND LEVEL

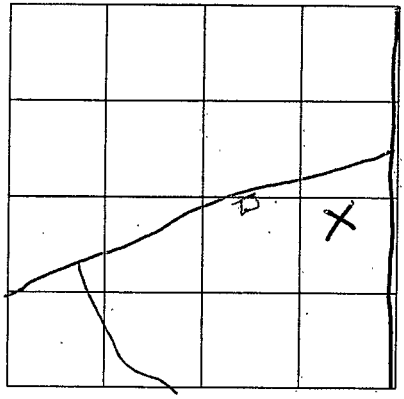

SECTION 11

Please indicate well location X.

ADDITIONAL INFORMATION

If more than one screen,
show location of each on sketch.